


6-2

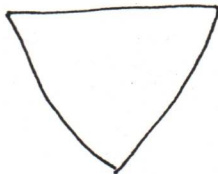

RIVER BEND

4" A.C.

34.0'

21.0'

6" A.C.

6-2

 10^{-1}

4" A.C.