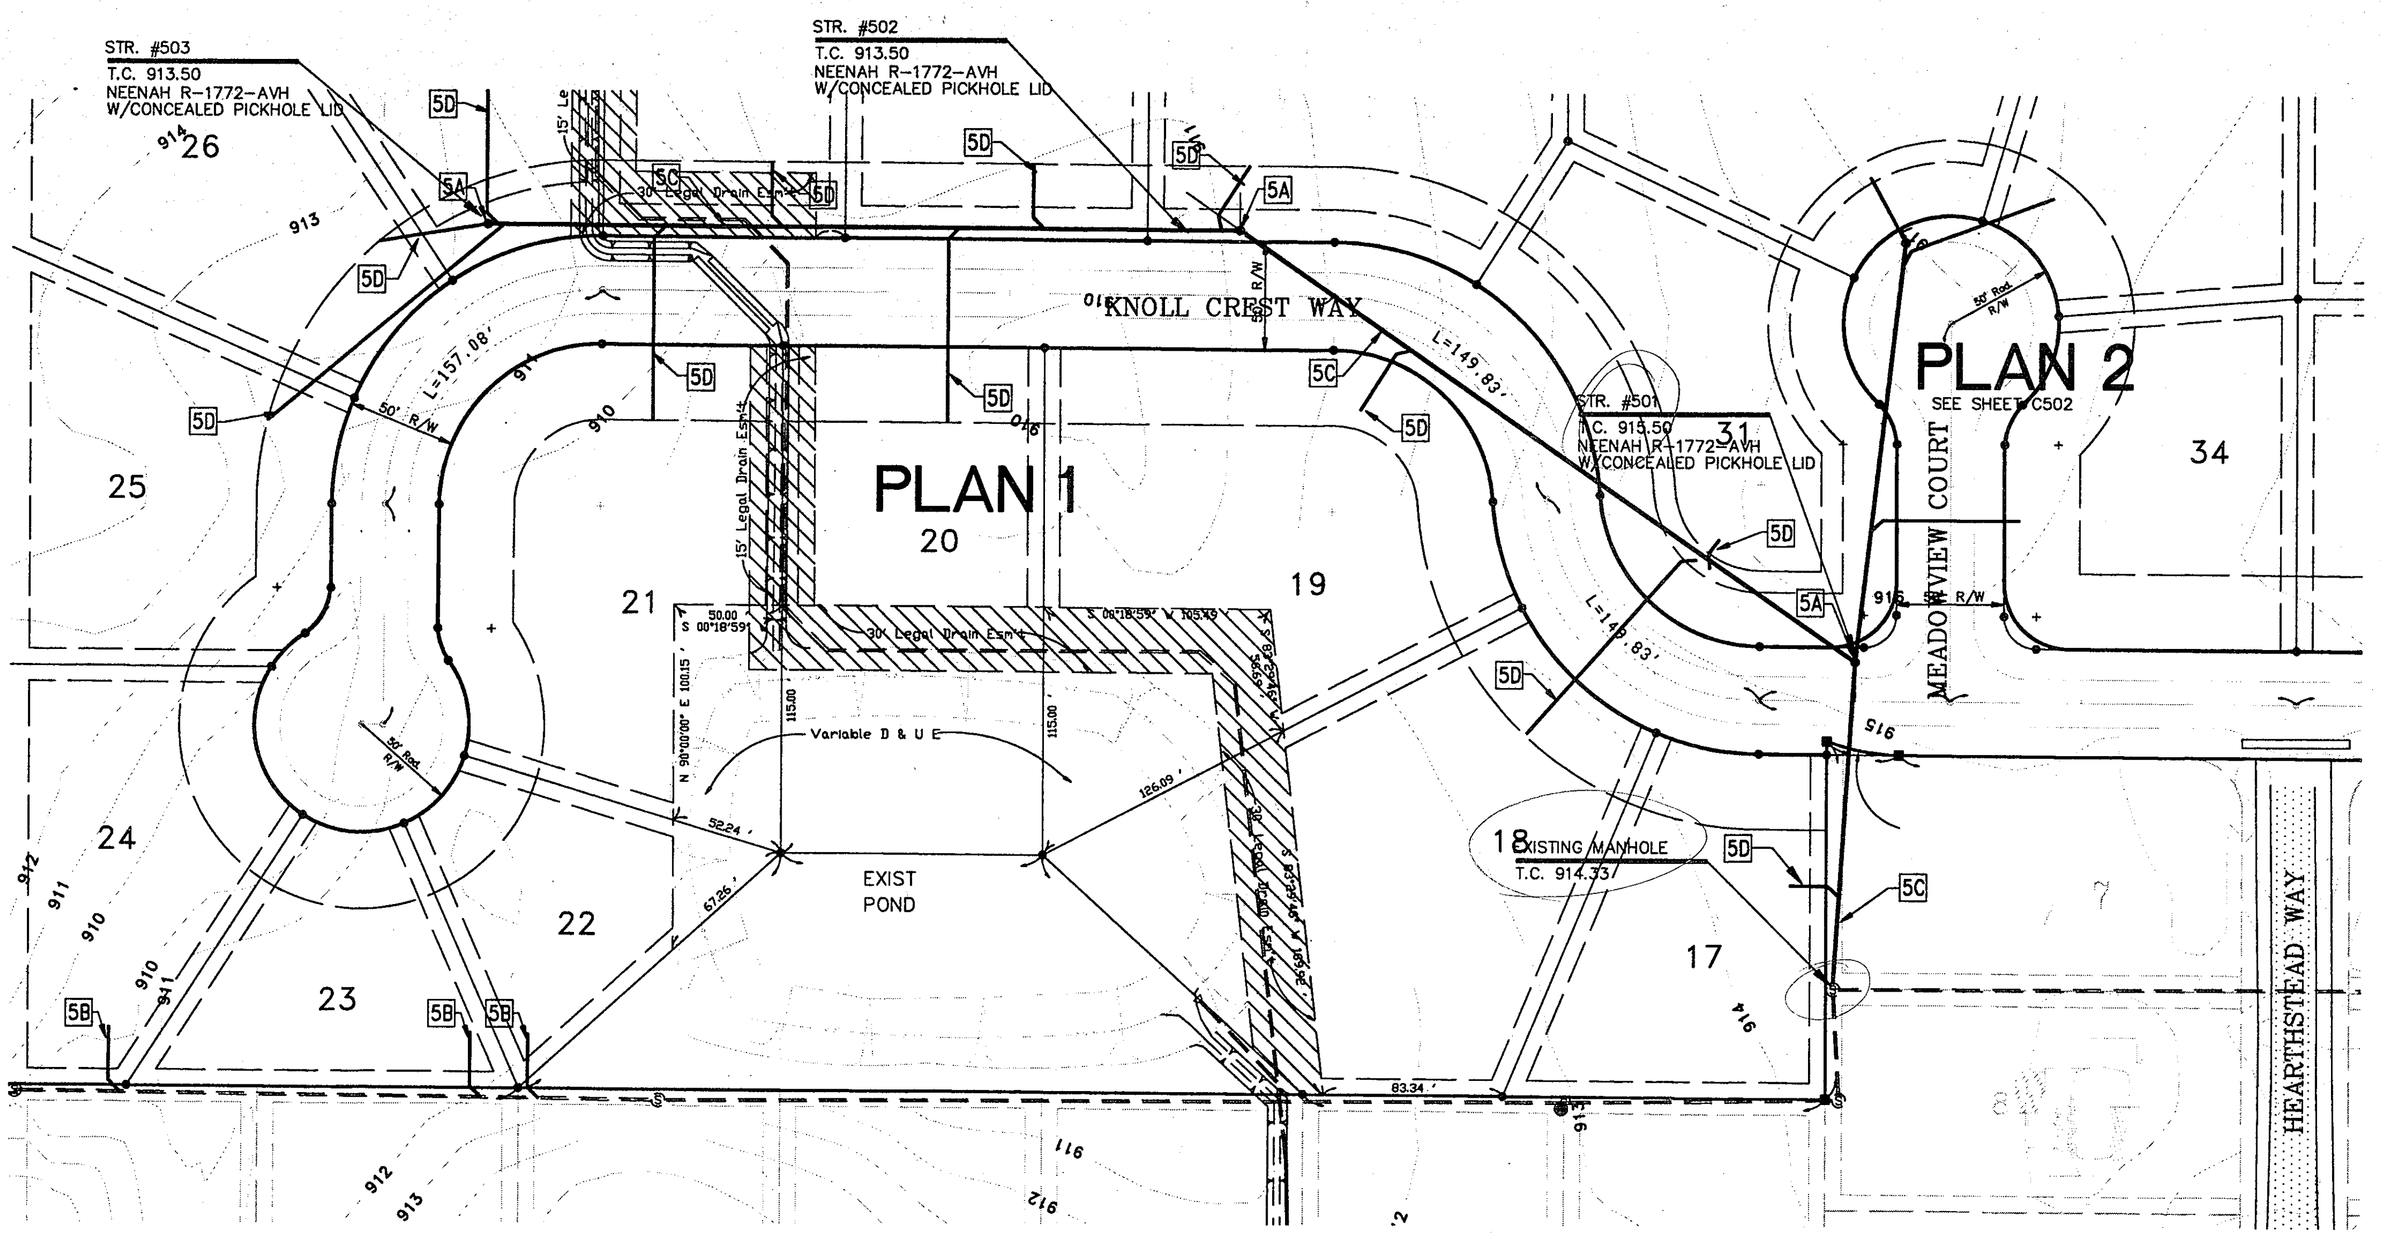

MINIMUM STANDARDS FOR SANITARY SEWER INSTALLATIION

1. Contractor shall maintain a minimum of 0.40% slope for all 8" sanitary sewer lines
2. Contractor shall maintain a maximum spacing between manholes of 500'..
3. All castings shall be Neenah R-1772-AVH with concealed pick-hole lid.
4. Contractor shall maintain a minimum depth of 5'-0" for all sanitary sewer line.
5. Contractor shall maintain a 0.10' drop across manholes.
6. All stationing shown on Plans is from the nearest down-stream manhole.
7. See Details for pipe bedding sections.
8. Contractor shall be responsible for notifying engineer of any discrepancies prior to commencement of work.
9. Contractor shall verify that all permits have been obtained prior to commencement of work.

RECEIVED
AUG 18 1994
WATER WASTEWATER
DESIGN CHECK OK

LEGEND • NTS

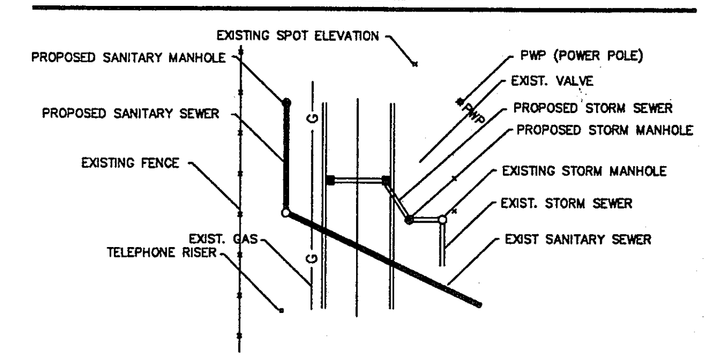

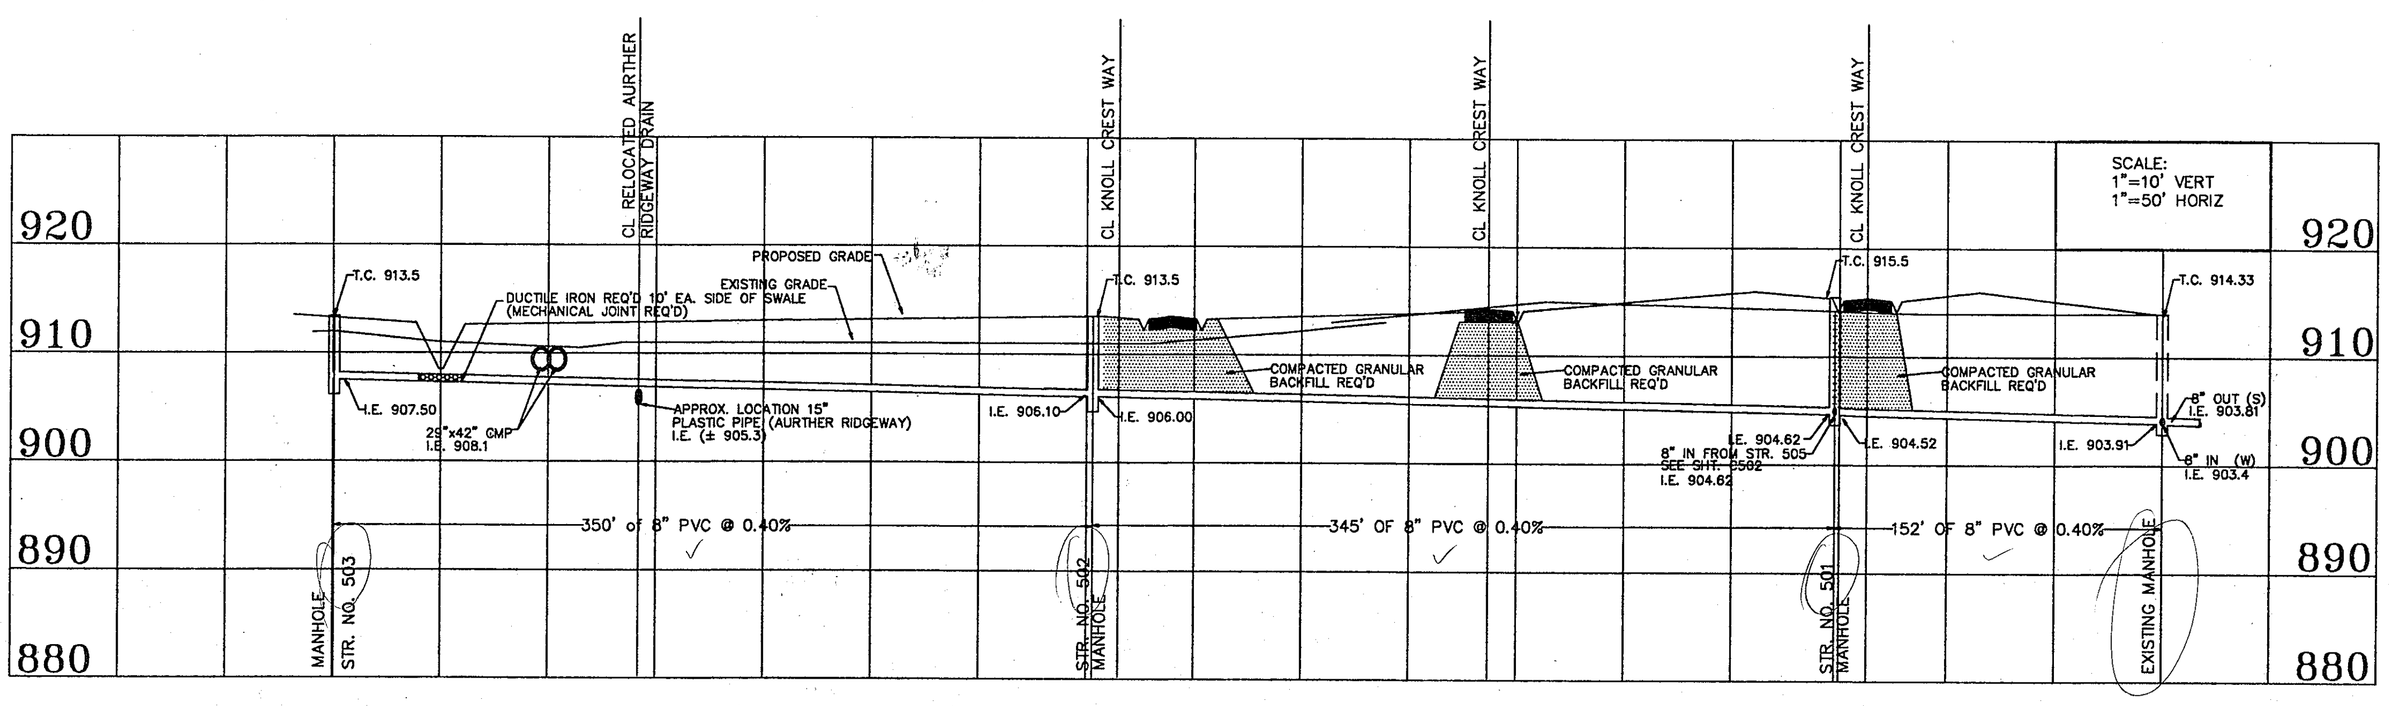

PROFILE 1

KEYNOTES

1A	LANDSCAPE MOUNDING (TYP.)
1B	EMERGENCY SPILLWAY (SEE DETAIL 3B SHT C801)
1C	AGGREGATE PAVEMENT (SEE DETAIL 1A C801)
2A	RIP-RAP (SEE DETAIL 2A SHT C802)
2B	TYPICAL SWALE (SEE DETAIL THIS SHT)
2C	SPECIAL SWALE (SEE DETAIL THIS SHT)
3A	STANDARD H.A.C. PAVEMENT (SEE DETAIL 1A C801)
3B	LIFT STATION ACCESS ROAD (SEE DETAIL 3B SHT C801)
4A	STANDARD STORM MANHOLE (SEE DETAIL 4A SHT C801)
4B	12" C.M.P.
4C	15" C.M.P.
4D	29" X 42" CMP (SEE DETAIL 4B SHT C901)
5A	STANDARD SANITARY MANHOLE (SEE DETAIL 5A SHT C801)
5B	6" PVC LATERAL INTO EXISTING SEWER (SEE DETAIL 5B SHT C801)
5C	8" PVC SEWER (SEE DETAIL SHT C801)
5D	6" PVC LATERAL (SEE DETAIL 5D SHT C801)
5E	EXTERIOR CLEANOUT (SEE DETAIL 5D SHT C801)

"DON'T DIG BLIND"
"IT'S THE LAW"
Call 1-800-382-5544
2 Working Days
Before You Dig.

JOSEPH C. BLAKE
REGISTERED
No.
PE#19300352
STATE OF
INDIANA
PROFESSIONAL ENGINEER

JOSEPH C. BLAKE, P.E. 8/25/95

SANITARY SEWER PLAN + PROFILE

Architectural Services And Permits
U-NAME-IT
WE-DO-IT
A.S.A.P. !
P.O. BOX 414
PENDLETON, IN 46064
(317) 778-8070
(317) 778-8053 (FAX)
DRAFTING CONSULTING PERMITS

Pendleton Consulting
P.O.Box 67
Pendleton, Indiana 46064-0067
Phone/Fax (317) 778-4540

DEVELOPED BY:
BLAKE DEVELOPERS
6569 West 100 South
New Palestine, IN 46163

REVISION LOG
5-10-95 (REV #1) RELOCATE SAN. SEWER
6-28-95 (REV #2) RELOCATE SAN. SEWER
7-25-95 (REV #3) RELOCATE SAN. SEWER

DATE: 4-07-95
file: 95506501
SHEET NO.
C501
JOB NO.
95506