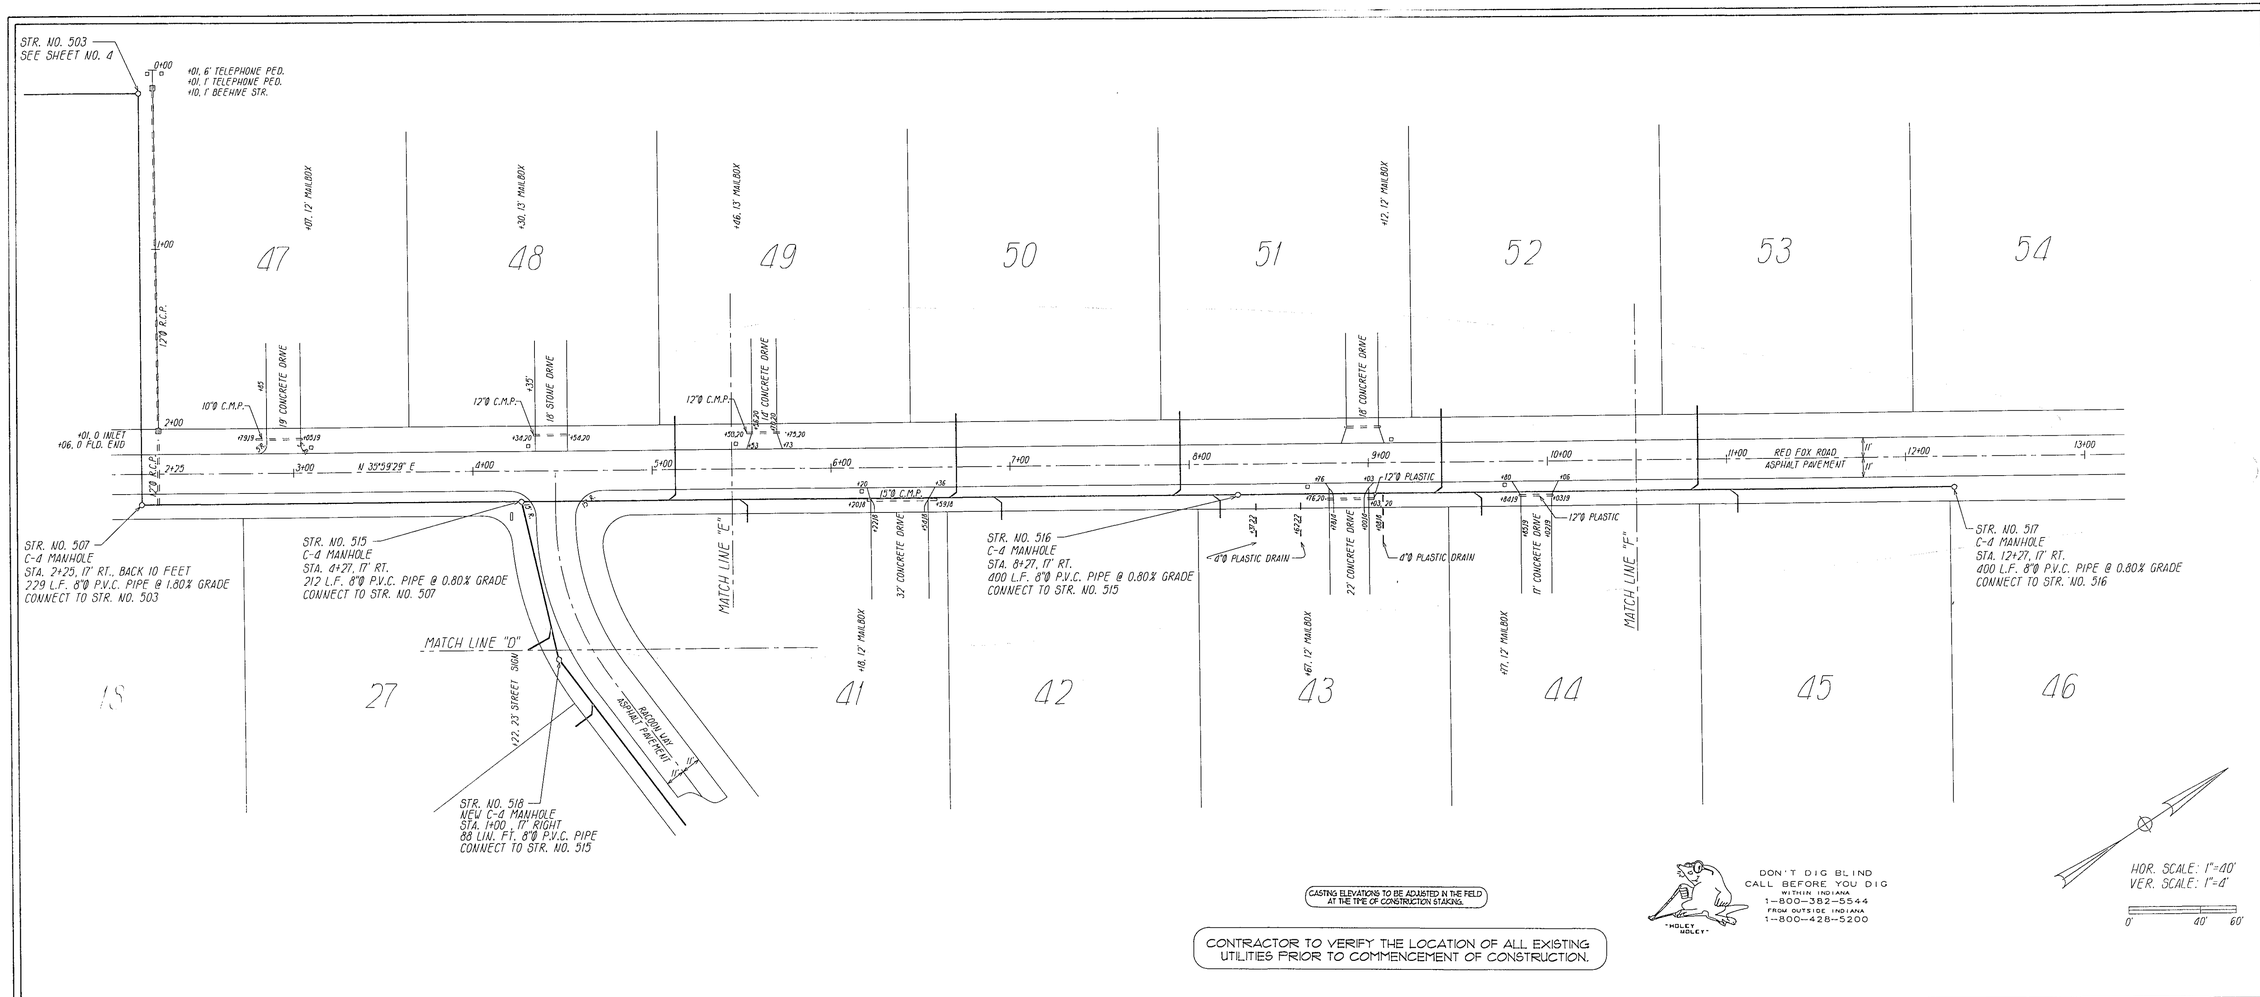

CASTING ELEVATIONS TO BE ADJUSTED IN THE FIELD AT THE TIME OF CONSTRUCTION STAKING.

CONTRACTOR TO VERIFY THE LOCATION OF ALL EXISTING UTILITIES PRIOR TO COMMENCEMENT OF CONSTRUCTION.

DON'T DIG BLIND
CALL BEFORE YOU DIG
WITHIN INDIANA
1-800-382-5544
FROM OUTSIDE INDIANA
1-800-428-5200

"HOLEY MOLEY"

HOR. SCALE: 1"=40'
VER. SCALE: 1"=4'

0' 40' 60'

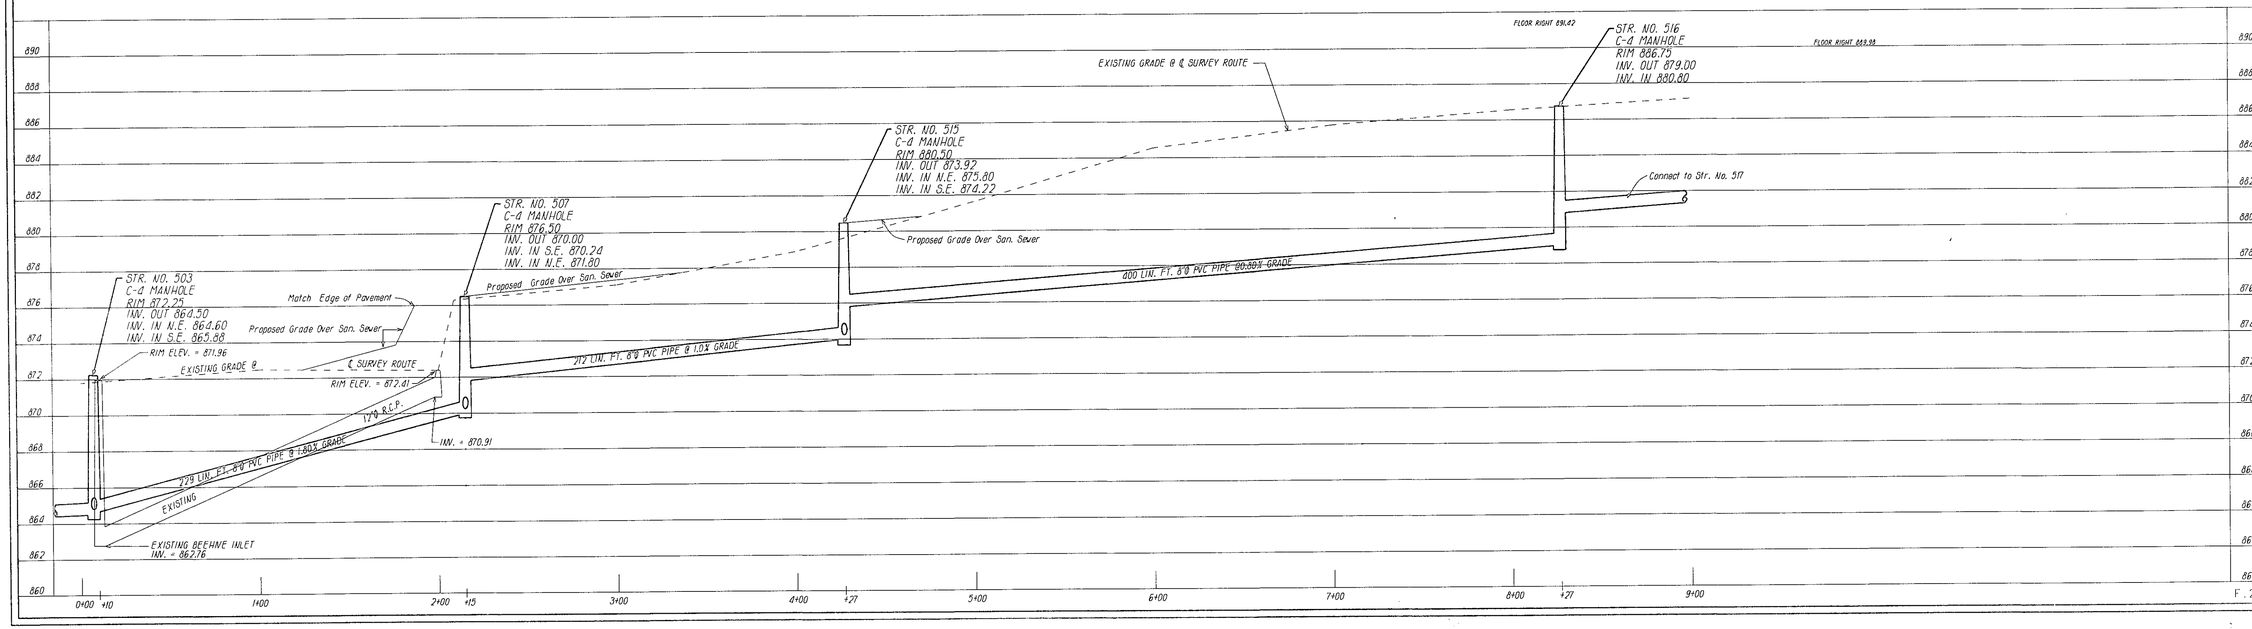

BRADLEY A. RAYL
SURVEYING & ENGINEERING
2036 MELODY LANE
ANDERSON, IN. 46012
(317) 643-5614

SANITARY SEWER PLAN AND PROFILES

REVISIONS: July 29, 1993 Add Str. No. 18 to Plan. Add Proposed Grade on Profile for San. Sewer Cover (P.A.N.)

HICKORY HILLS EAST
FALL CREEK TOWNSHIP
MADISON COUNTY, INDIANA

DRAWN BY: Perry A. Nerum

DATE MAY 17, 1993

BRADLEY A. RAYL
REGISTERED
LP 14901
STATE OF INDIANA
PROFESSIONAL ENGINEER

BY Bradley A. Rayl

DATE: 6-4-93

SHEET
61

Filmed OCT 06 1993