SANITARY SEWER AS-BUILTS

HICKORY HILLS EAST SECTION THREE

INDEX

SHEET NO.	DESCRIPTION
1	TITLE SHEET
2 & 3	UTILITY PLAN
4 - 6	SANITARY SEWER PROFILES

REVISIONS

SHEET NO.	DESCRIPTION

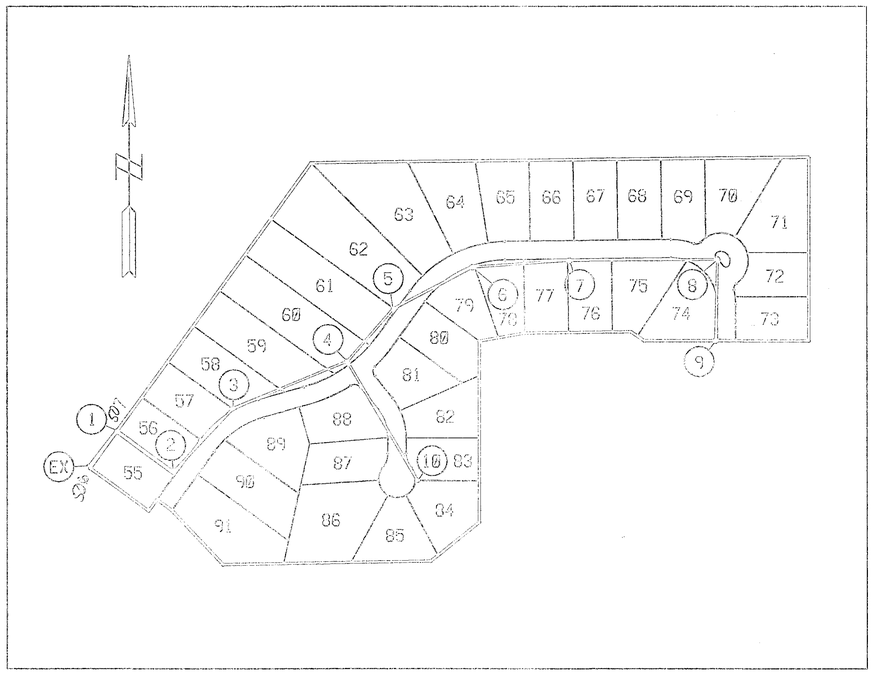

SITE LAYOUT

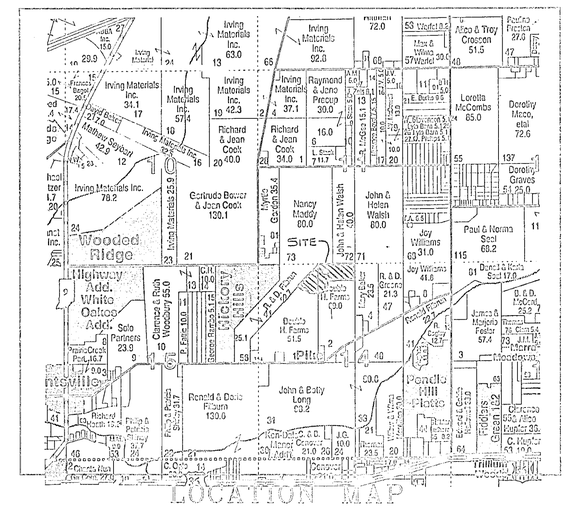

LOCATION MAP

PREPARED FOR:

TRIAD ASSOCIATES, INC.
520 VIRGINIA AVENUE
INDIANAPOLIS, INDIANA 46203

PREPARED BY:

a division of HALBERT'S ENGINEERING & CONTRACTING, INC.
CONSULTING ENGINEERS ~ DEVELOPMENT ~ LAND PLANNING

301 John Street
Telephone (317) 630-1552

Anderson, Indiana 46016
Facsimile (317) 622-5031

CERTIFIED THIS 17TH DAY OF APRIL 1996

Stephen D. Servies
Registered Professional Engineer No. 9500299-Indiana

STEPHEN D. SERVIES
No. 9500299
STATE OF
INDIANA
PROFESSIONAL ENGINEER

SHEET 1 OF 6

94S027