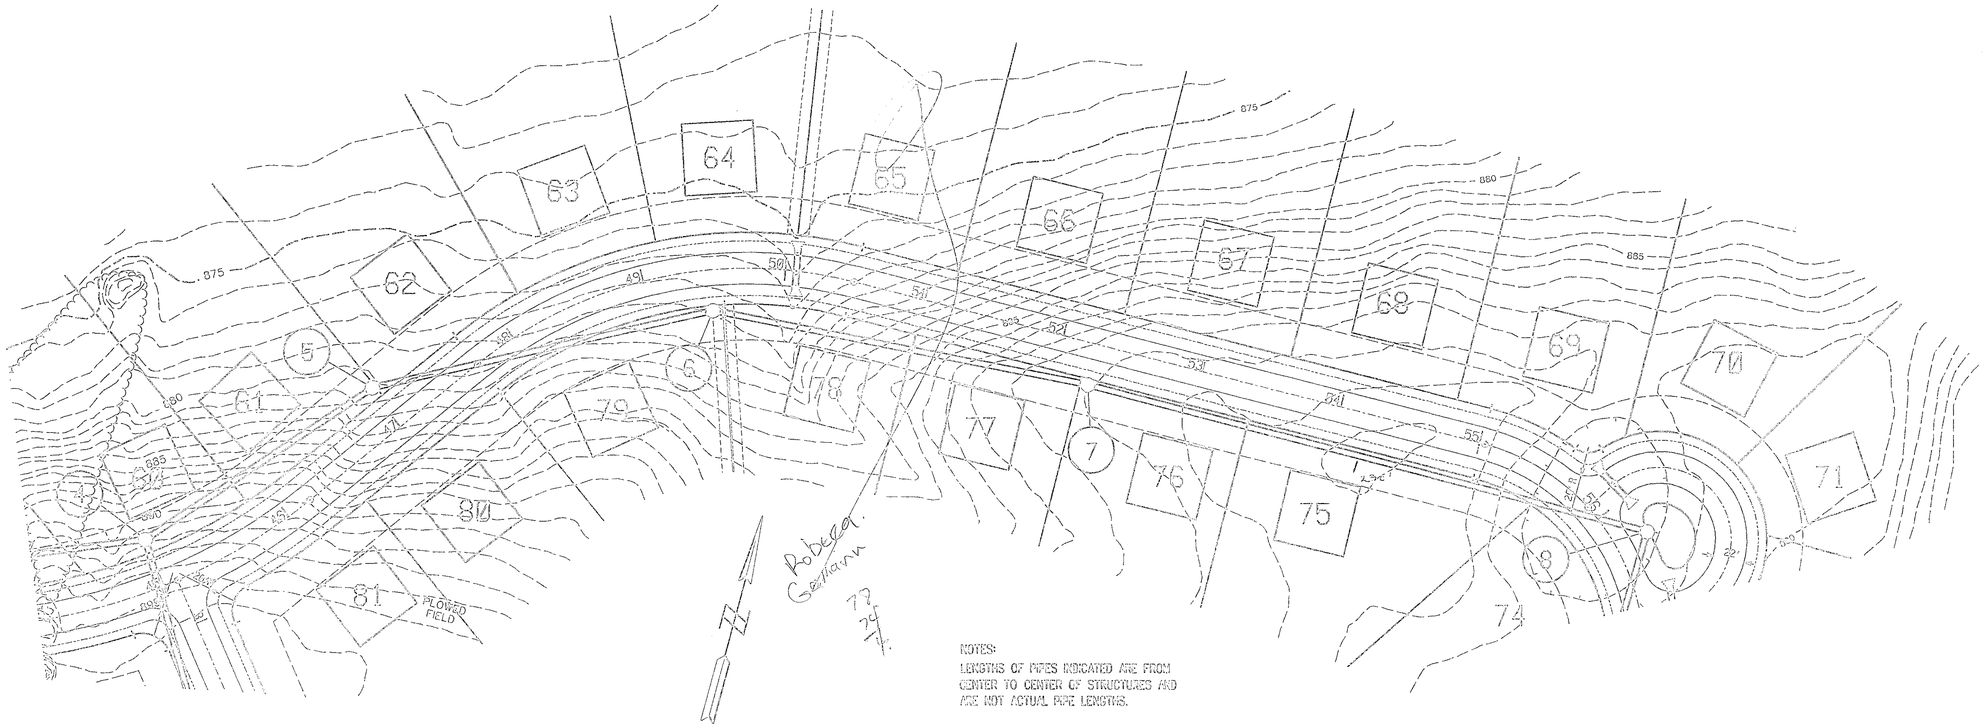
875
880
