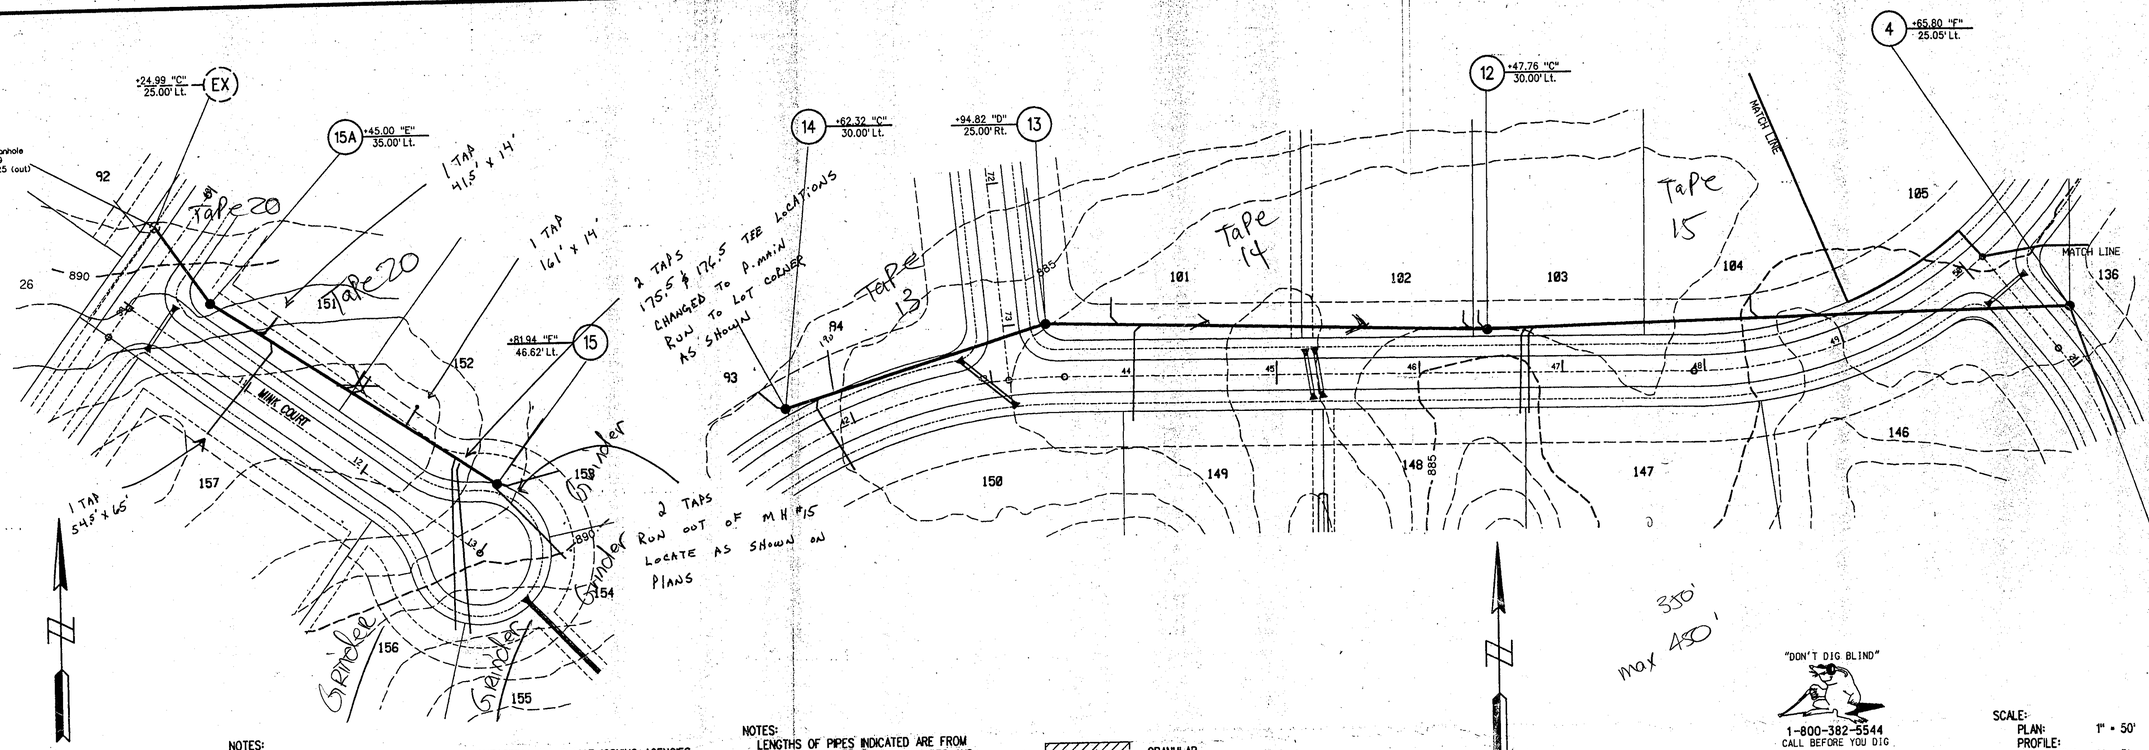

NOTES:
CONTRACTOR SHALL BE RESPONSIBLE FOR CONTACTING ALL PERMIT ISSUING AGENCIES WITHIN THE TIME FRAME SPECIFIED BY THAT AGENCY PRIOR TO BEGINNING CONSTRUCTION

NOTES:
LENGTHS OF PIPES INDICATED ARE FROM CENTER TO CENTER OF STRUCTURES AND ARE NOT ACTUAL PIPE LENGTHS.

GRANULAR BACKFILL

SCALE:
PLAN: 1" = 50'
PROFILE:
VERTICAL 1" = 5'
HORIZONTAL 1" = 50'

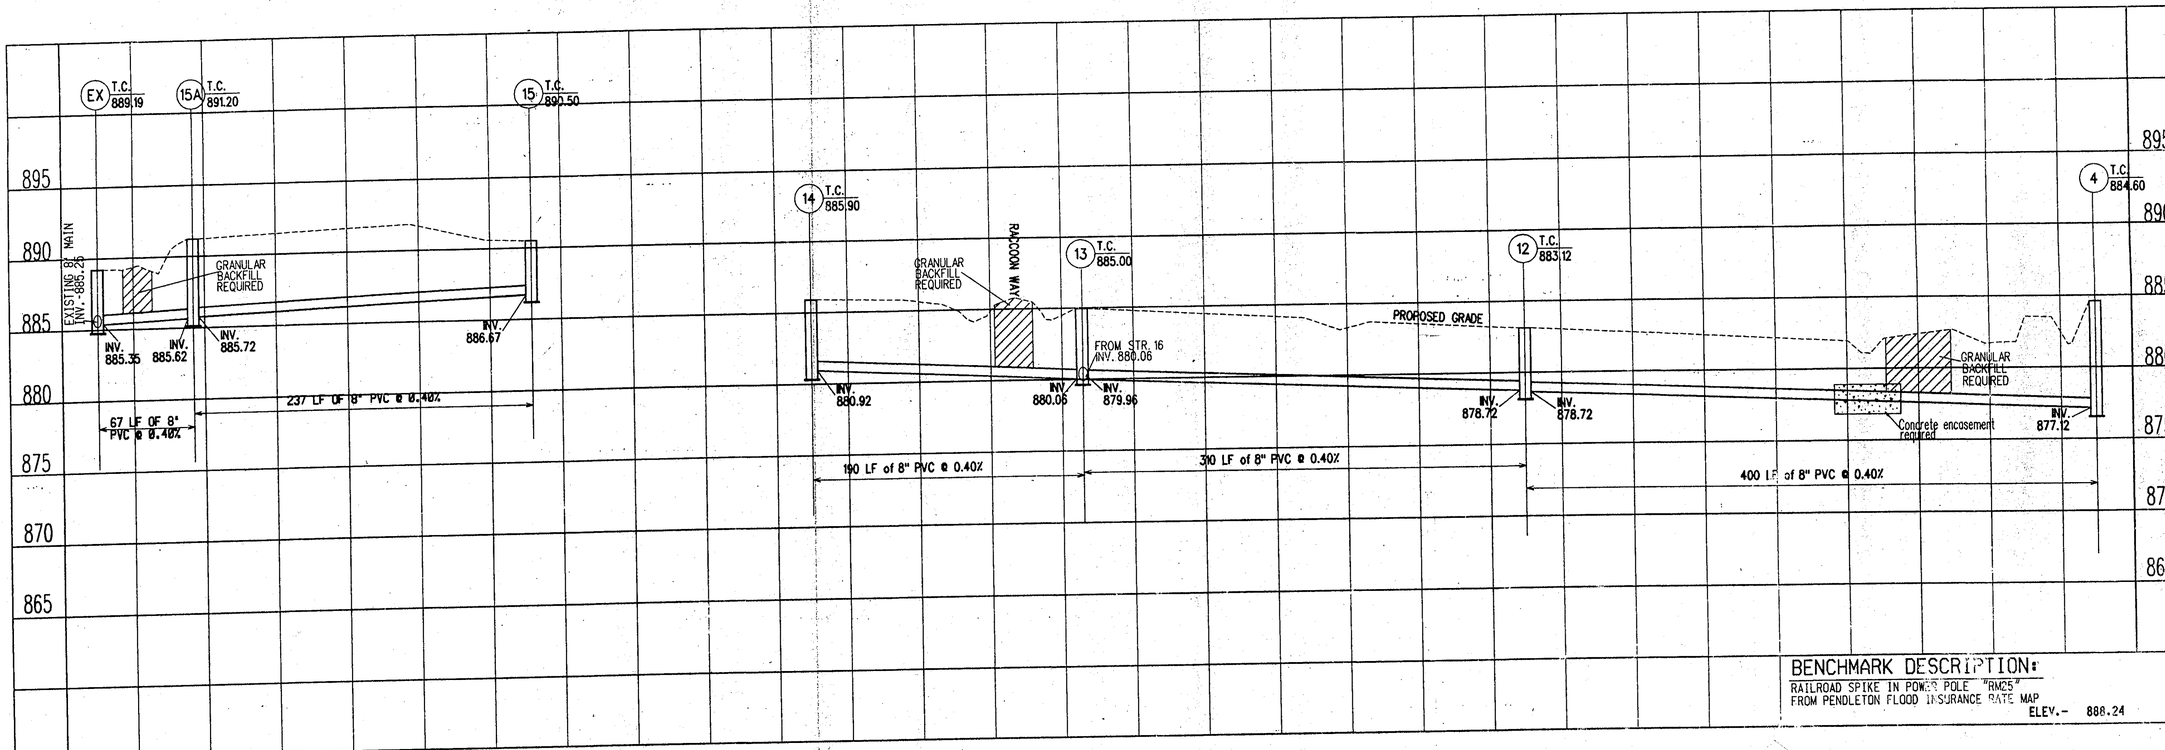

BENCHMARK DESCRIPTION:
RAILROAD SPIKE IN POWER POLE "RM25"
FROM PENDLETON FLOOD INSURANCE RATE MAP
ELEV.- 888.24

JAY B. GIBSON
No. 920005
STATE OF INDIANA
PROFESSIONAL ENGINEER
CERTIFIED BY:

a division of M.K.BETTS ENGINEERING & CONTRACTING, INC.
CONSULTING ENGINEERS - DEVELOPMENT - LAND SURVEYING
110 ½ North Lafayette Street
Telephone (317) 482-0235
Lafayette, Indiana 46052
Facsimile (317) 482-0237

FILE DATE
5-19-95
Revised 8-18-95

SANITARY SEWER PROFILES

SCALE: 1" = 50'
DRAWN BY: GSM

Project:
Hickory Hills
Section 4
Madison County, Indiana
developed by:
Double H Farms

SHEET #
12

PROJECT NO.
95S025