


NOTES:
CONTRACTOR SHALL BE RESPONSIBLE FOR CONTACTING ALL PERMIT ISSUING AGENCIES WITHIN THE TIME FRAME SPECIFIED BY THAT AGENCY PRIOR TO BEGINNING CONSTRUCTION

NOTES:
LENGTHS OF PIPES INDICATED ARE FROM CENTER TO CENTER OF STRUCTURES AND ARE NOT ACTUAL PIPE LENGTHS.

GRANULAR BACKFILL

SCALE:
PLAN: 1" = 50'
PROFILE: VERTICAL 1" = 5'
HORIZONTAL 1" = 50'

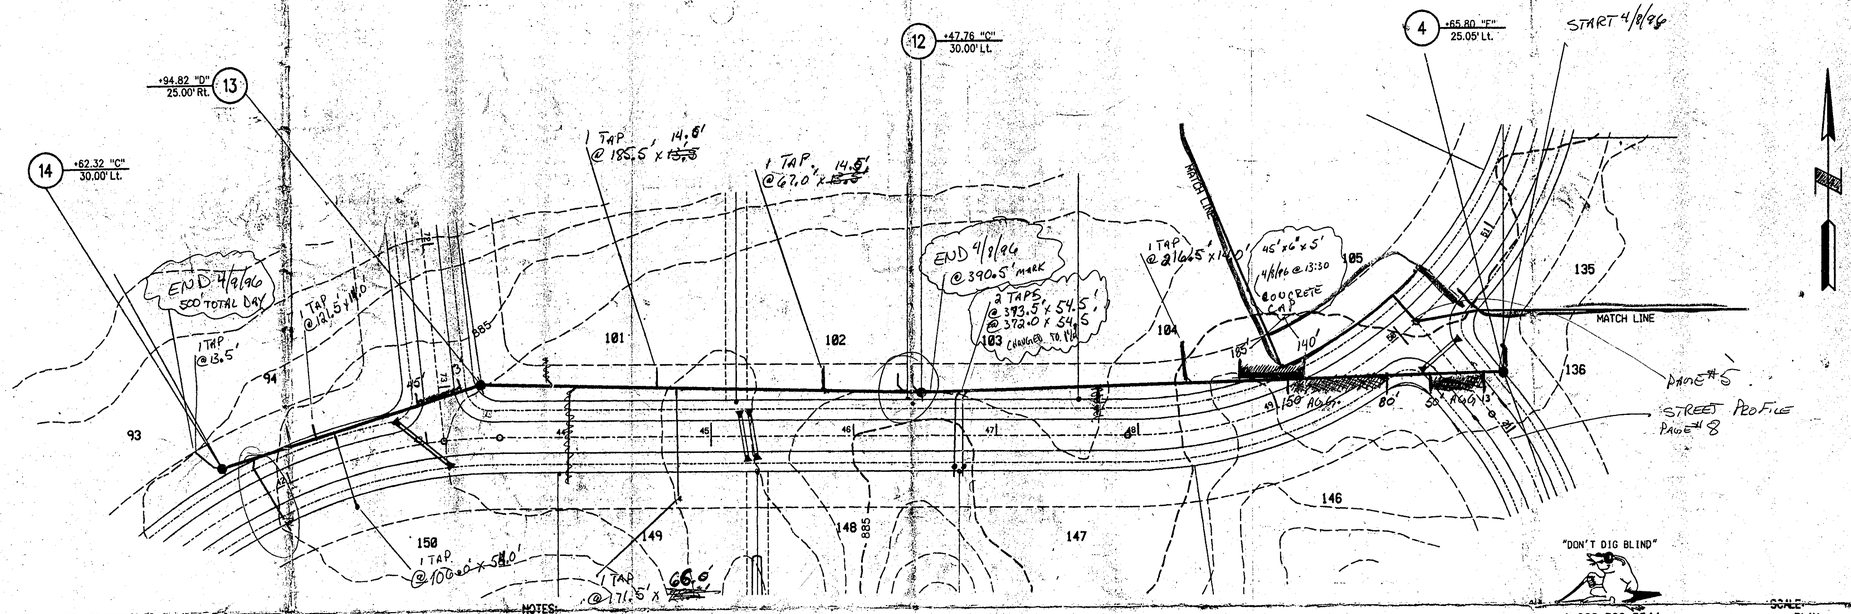


BENCHMARK DESCRIPTION:
RAILROAD SPIKE IN POWER POLE "RM25"
FROM PENDLETON FLOOD INSURANCE RATE MAP
ELEV.- 888.24

JAY B. GIBSON
No. 920005
STATE OF INDIANA
PROFESSIONAL ENGINEER
CERTIFIED BY:

a division of M.K. BETTS ENGINEERING & CONTRACTING, INC.
CONSULTING ENGINEERS - DEVELOPMENT - LAND SURVEYING
Lebanon, Indiana 46052
112 ½ North Lebanon Street
Telephone (317) 482-0257
Facsimile (317) 482-0258

FILE DATE
5-19-95

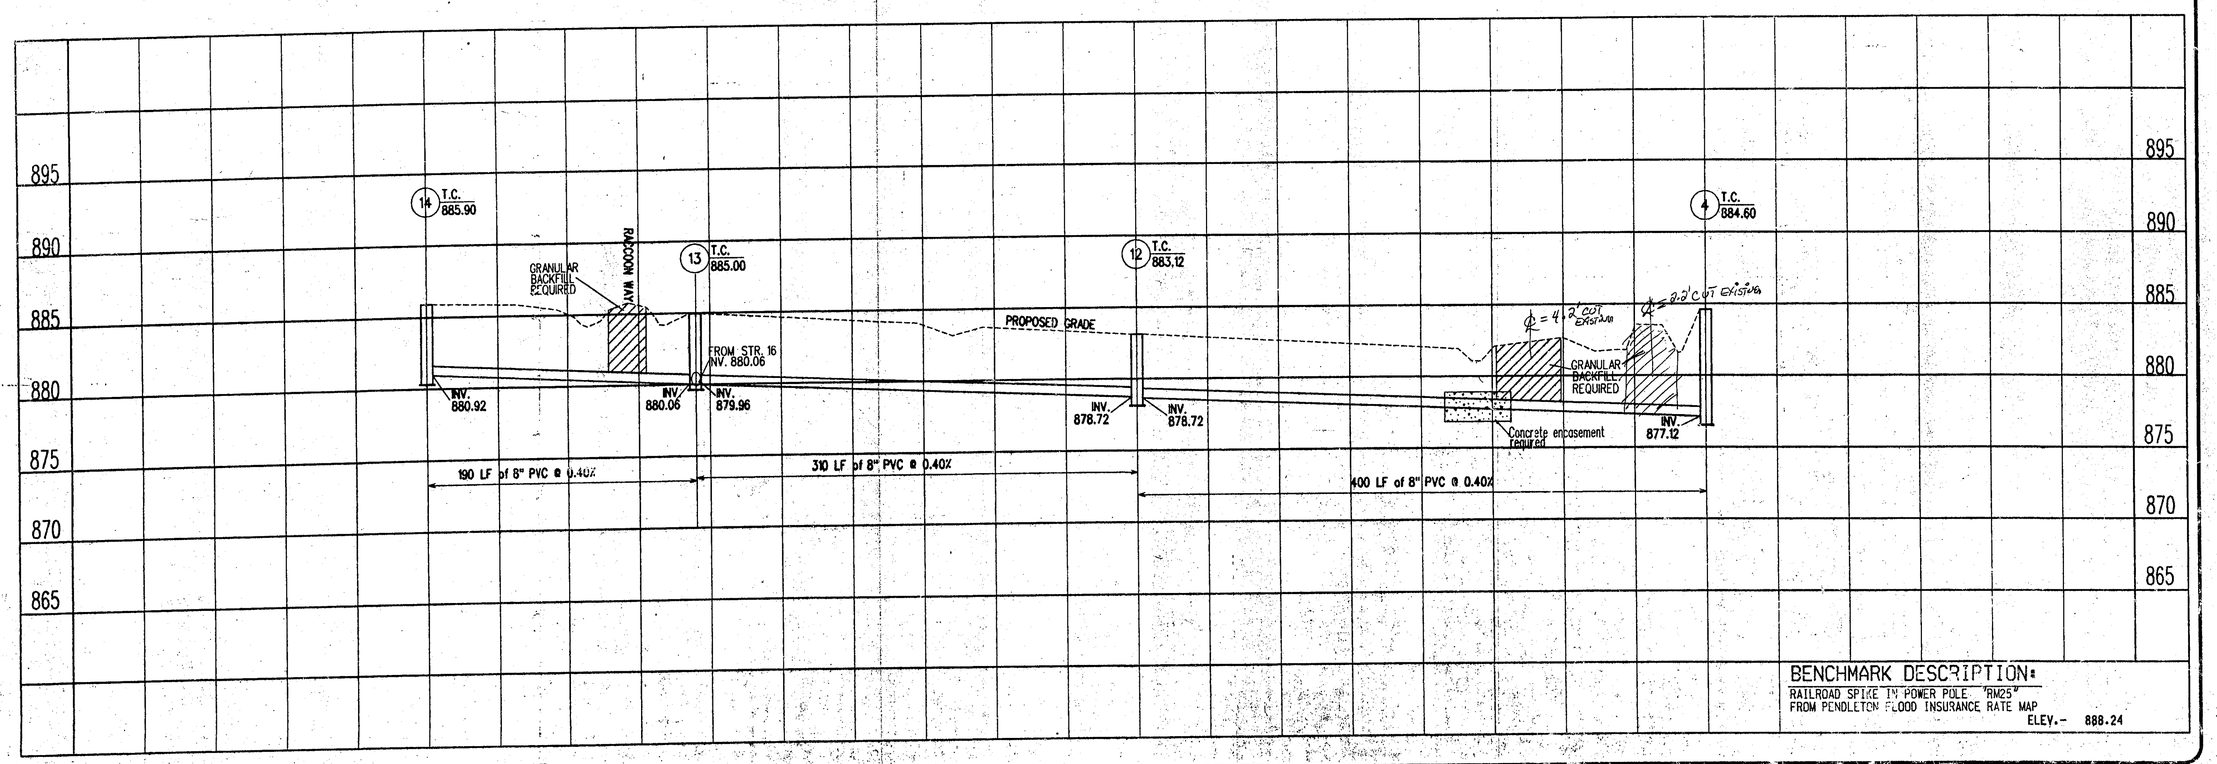SANITARY SEWER PROFILES

| SCALE: | DRAWN BY: |
|---|---|
| 1" = 50' | GSV |

Project:
Hickory Hills
Section 4
Madison County, Indiana
developed by:
Double H Farms

SHEET #
12