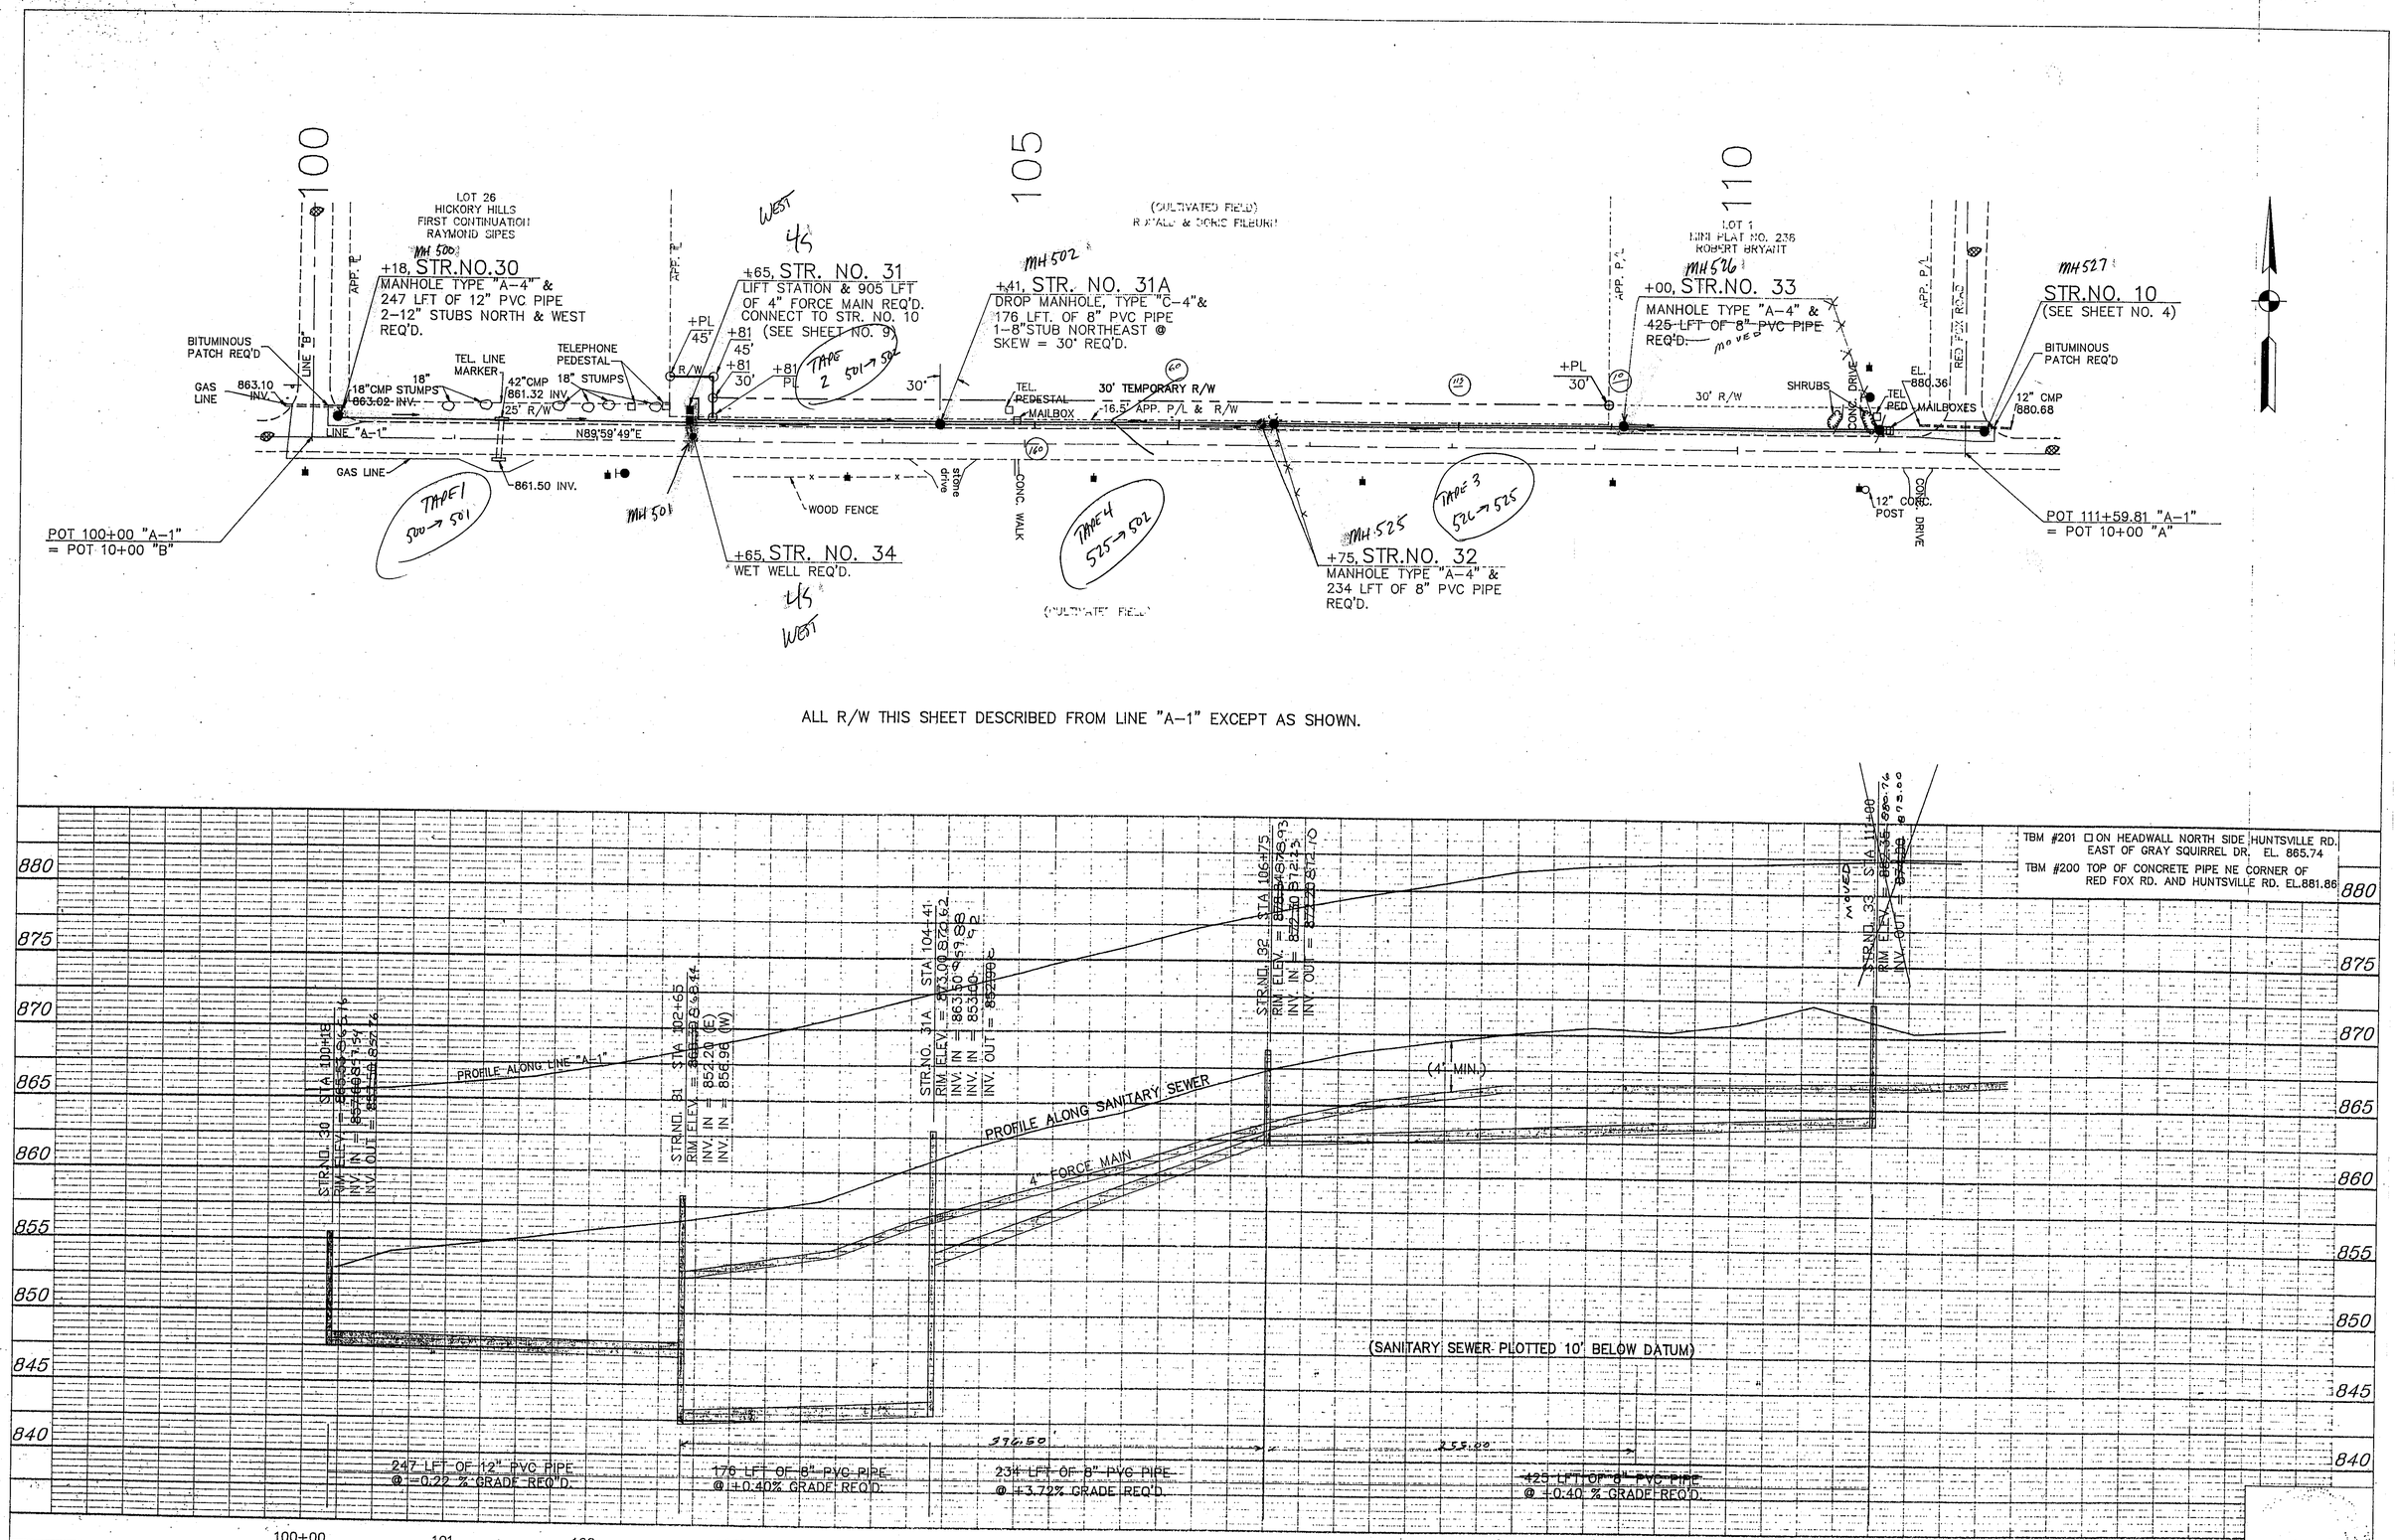

F.C.R.W.D. HUNTSVILLE ROAD SEWER

NO	DATE	DESCRIPTION	BY
		JOB NO. 9236	
1	12/11/92	STR.NO.31"A" HIC. HILLS EAST	RD/MF
	10/3/92	9236/9236-1	MGF

DURHAM Engineering
12 W. 8th STREET ANDERSON, INDIANA
(317)644-3833

SCALE VER. 1"= 5' HOR. 1"= 50'

SHEET NO. 3 of 9