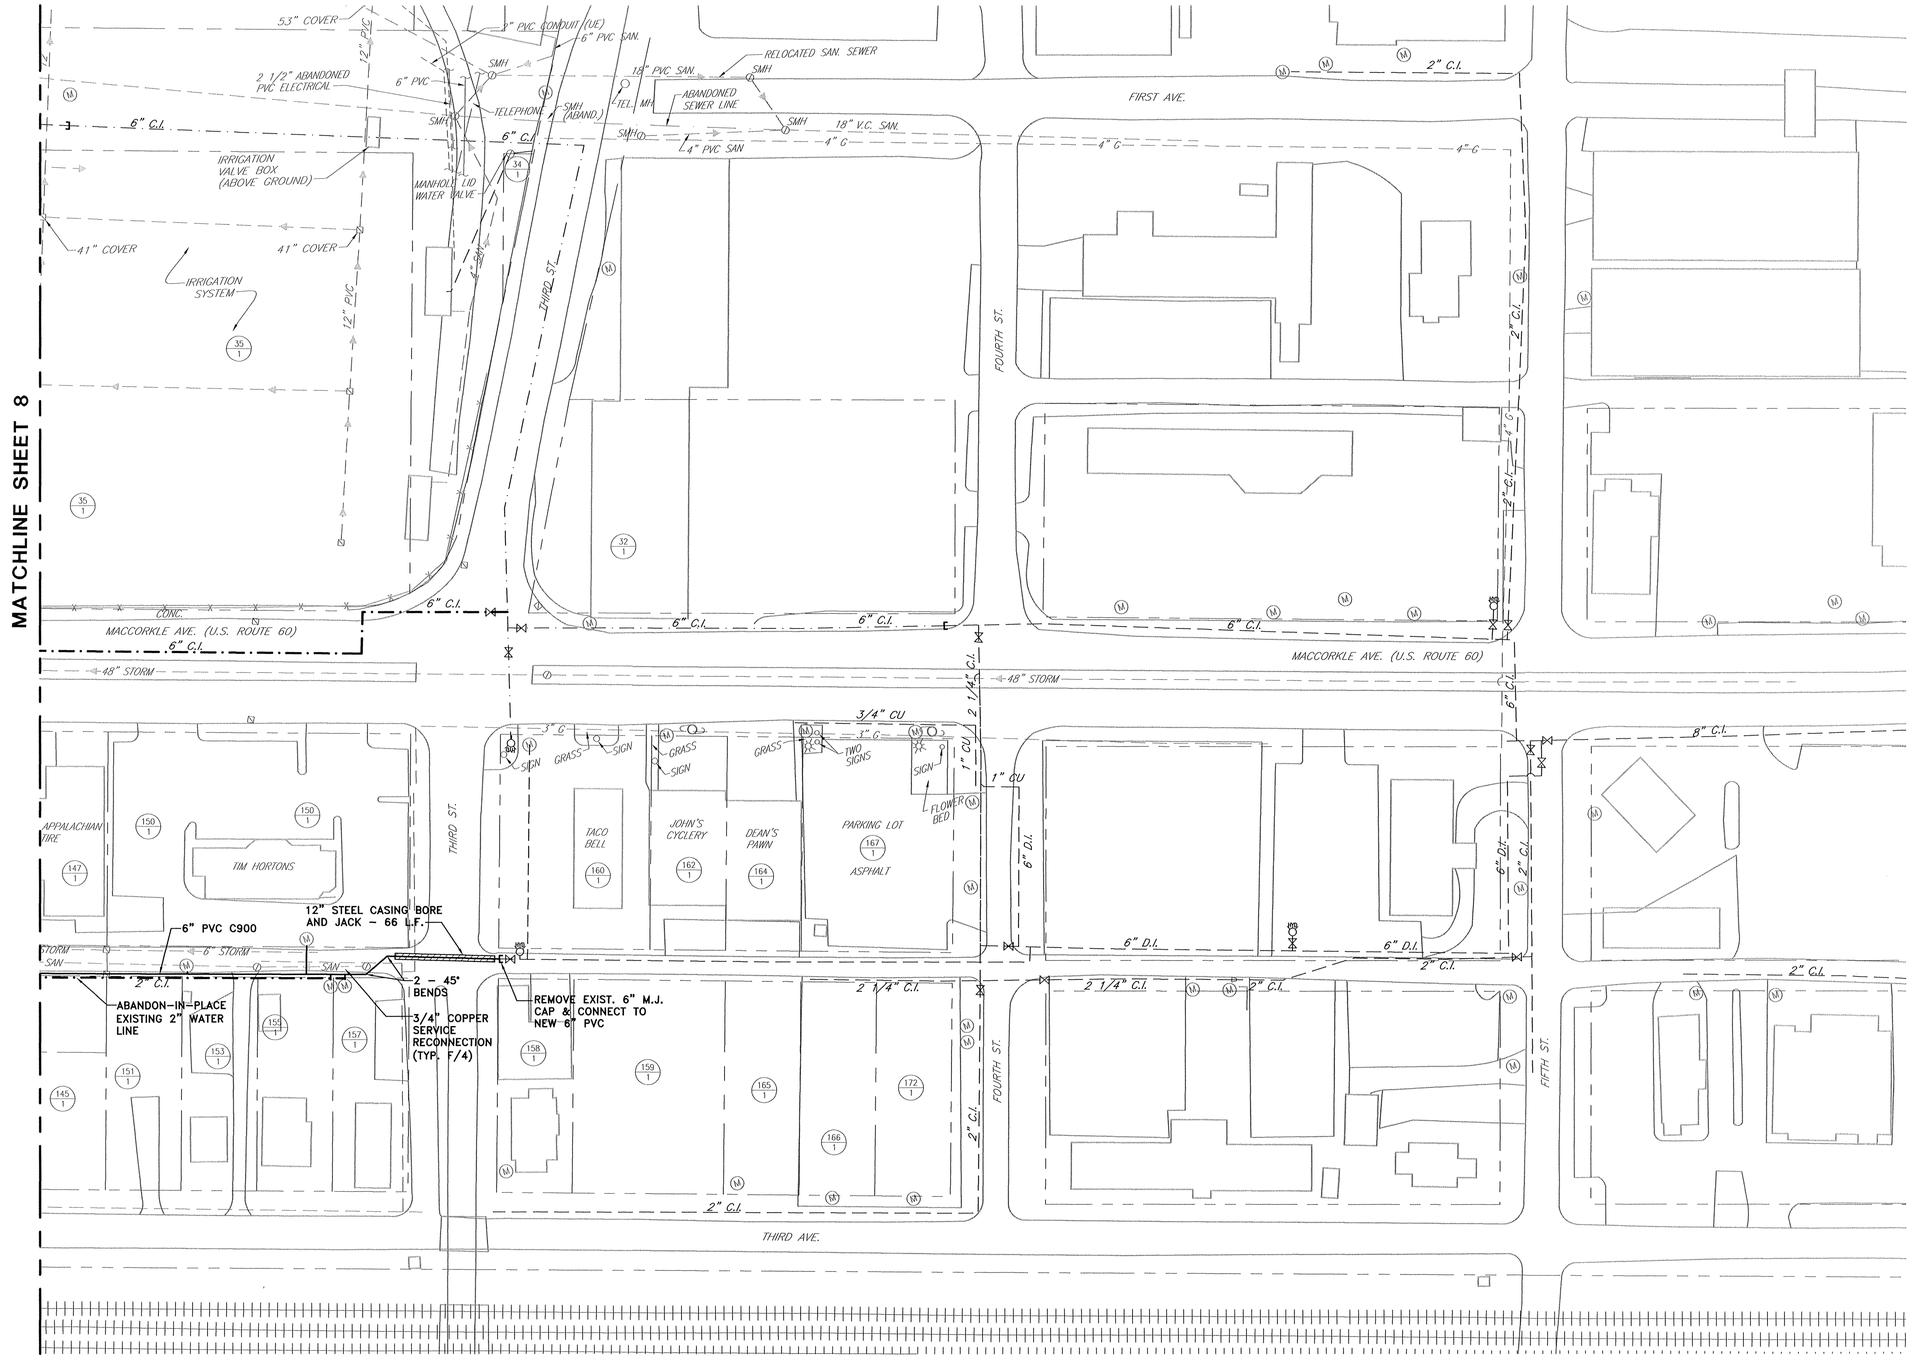


## RECORD DRAWINGS

These Record Drawings have been prepared based on information provided by others. While this information is believed reliable, Chapman Technical Group, Ltd. cannot assure the accuracy, and/or completeness of this information, and thus shall not be responsible for any errors or omissions which may be incorporated herein as a result. Those relying on this record drawing document are advised to obtain independent verification of its accuracy before applying it for any purpose.

August 2013

NORTH

GRAPHIC SCALE

50 0 25 50 100 200

1 inch = 50'

| REVISION NUMBER | REVISIONS | DATE | BY |
|---|---|---|---|
| | | | |


Chapman Technical Group

AIRPORT PLANNING / DEVELOPMENT
ARCHITECTURE / INTERIOR DESIGN
CIVIL ENGINEERING / SITE DEVELOPMENT
ENVIRONMENTAL ENGINEERING
LANDSCAPE ARCHITECTURE
SURVEYING

St. Albans, WV (304) 727-5501
Buckhannon, WV (304) 472-8914
Martinsburg, WV (304) 260-1222
www.chaptech.com


PROJECT INFORMATION

**ST. ALBANS MUNICIPAL UTILITY COMMISSION**
**ST. ALBANS, WEST VIRGINIA**
**WATER SYSTEM IMPROVEMENTS**
**CONTRACT NO. 4 - DISTRIBUTION SYSTEM**

**PLAN SHEET**

ROBERT G. BELCHER REGISTERED 14095 STATE OF WEST VIRGINIA PROFESSIONAL ENGINEER

| | |
|---|---|
| JOB NUMBER: | 08053 |
| SCALE: | 1" = 50' |
| DATE: | JUNE 2010 |
| DRAWN BY: | FLB |
| DESIGNED BY: | KTC |
| CHECKED BY: | RGB |
| SHEET NO. | 9 |
| REVISION | |

H:\Projects\08\08053\CAD\WATERLINE CONST\contract 4\RECORD DWGS\08053-RD-c4-09.dwg, 8/13/2014 8:59:53 AM, lde91