LEGEND

—·—·—	EXISTING WATERLINE TO BE ABANDONED-IN-PLACE
———	PROPERTY LINE
━━━	NEW WATERLINE
— — —	EXIST. WATERLINE TO REMAIN

RECORD DRAWINGS

These Record Drawings have been prepared based on information provided by others. While this information is believed reliable, Chapman Technical Group, Ltd. cannot assure the accuracy, and/or completeness of this information, and thus shall not be responsible for any errors or omissions which may be incorporated herein as a result. Those relying on this record drawing document are advised to obtain independent verification of its accuracy before applying it for any purpose.

SEPTEMBER 2012

CONNECTION NO. 4-A
SCALE: 1" = 20'

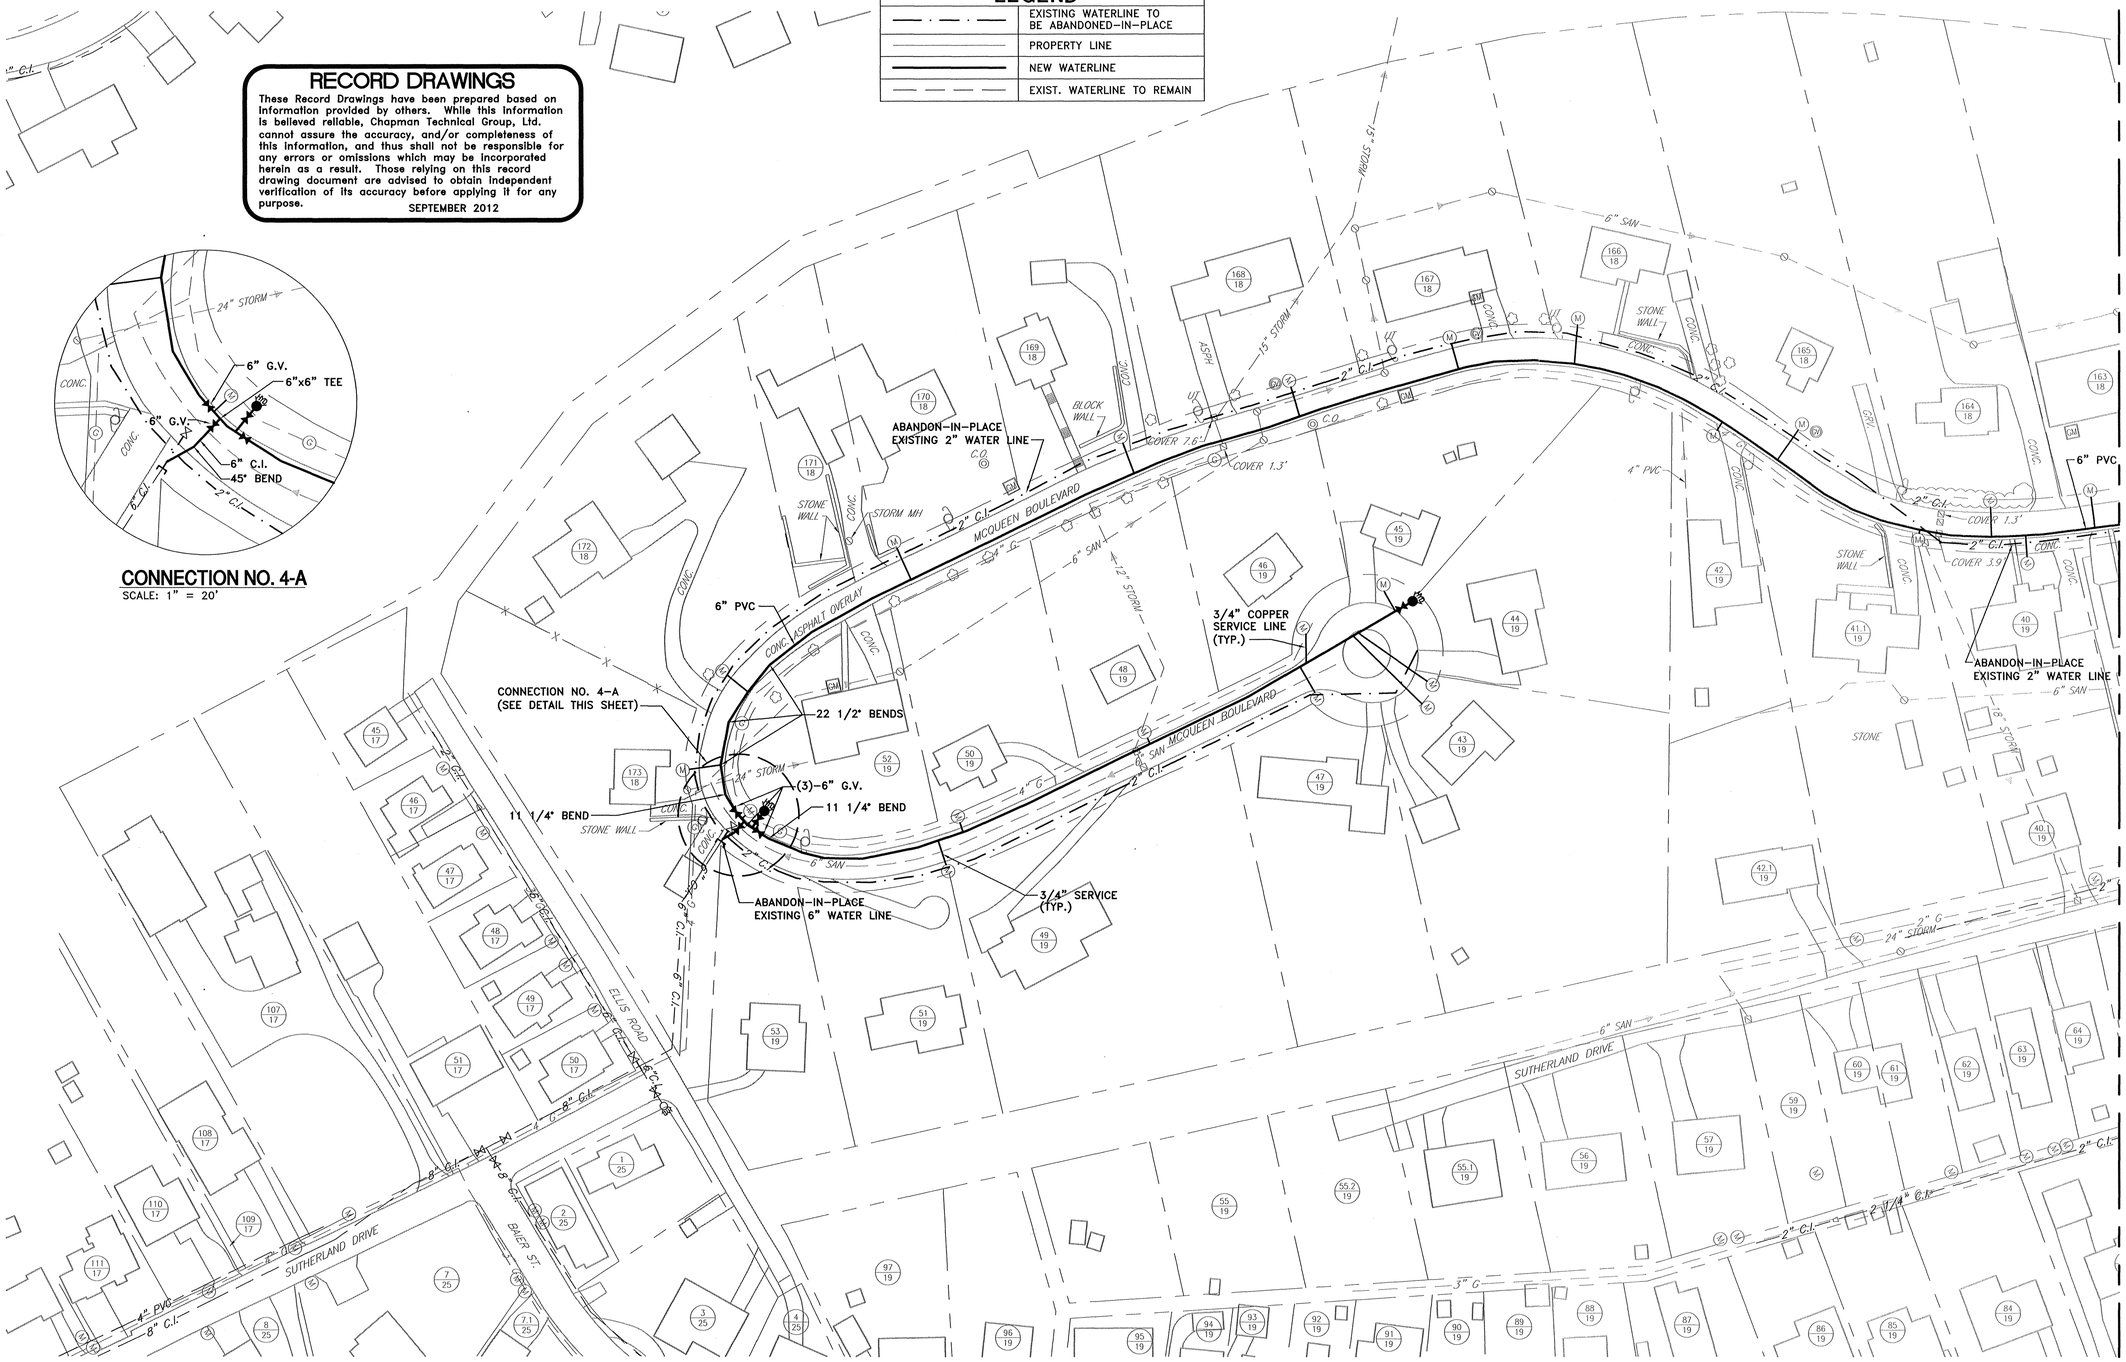

REVISION NUMBER	REVISIONS	DATE	BY

Chapman Technical Group

AIRPORT PLANNING / DEVELOPMENT
ARCHITECTURE / INTERIOR DESIGN
CIVIL ENGINEERING / SITE DEVELOPMENT
ENVIRONMENTAL ENGINEERING
LANDSCAPE ARCHITECTURE
SURVEYING

St. Albans, WV (304) 727-5501
Buckhannon, WV (304) 472-8914
Martinsburg, WV (304) 260-1222
www.chaptech.com

PROJECT INFORMATION

ST. ALBANS MUNICIPAL UTILITY COMMISSION
ST. ALBANS, WEST VIRGINIA
WATER SYSTEM IMPROVEMENTS
CONTRACT NO. 2 - DISTRIBUTION SYSTEM

PLAN SHEET

SEAL: ROBERT G. BELCHER, REGISTERED, 9307, STATE OF WEST VIRGINIA, PROFESSIONAL ENGINEER

JOB NUMBER:	08053
SCALE:	1" = 50'
DATE:	MAY 2010
DRAWN BY:	FLB
DESIGNED BY:	MJC
CHECKED BY:	RGB/JDE
SHEET NO.	4
REVISION	