

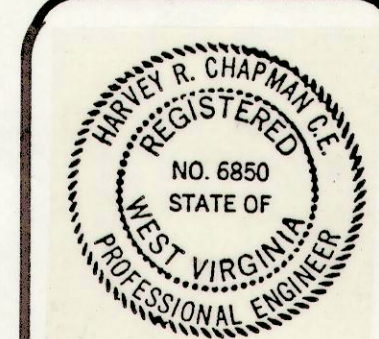


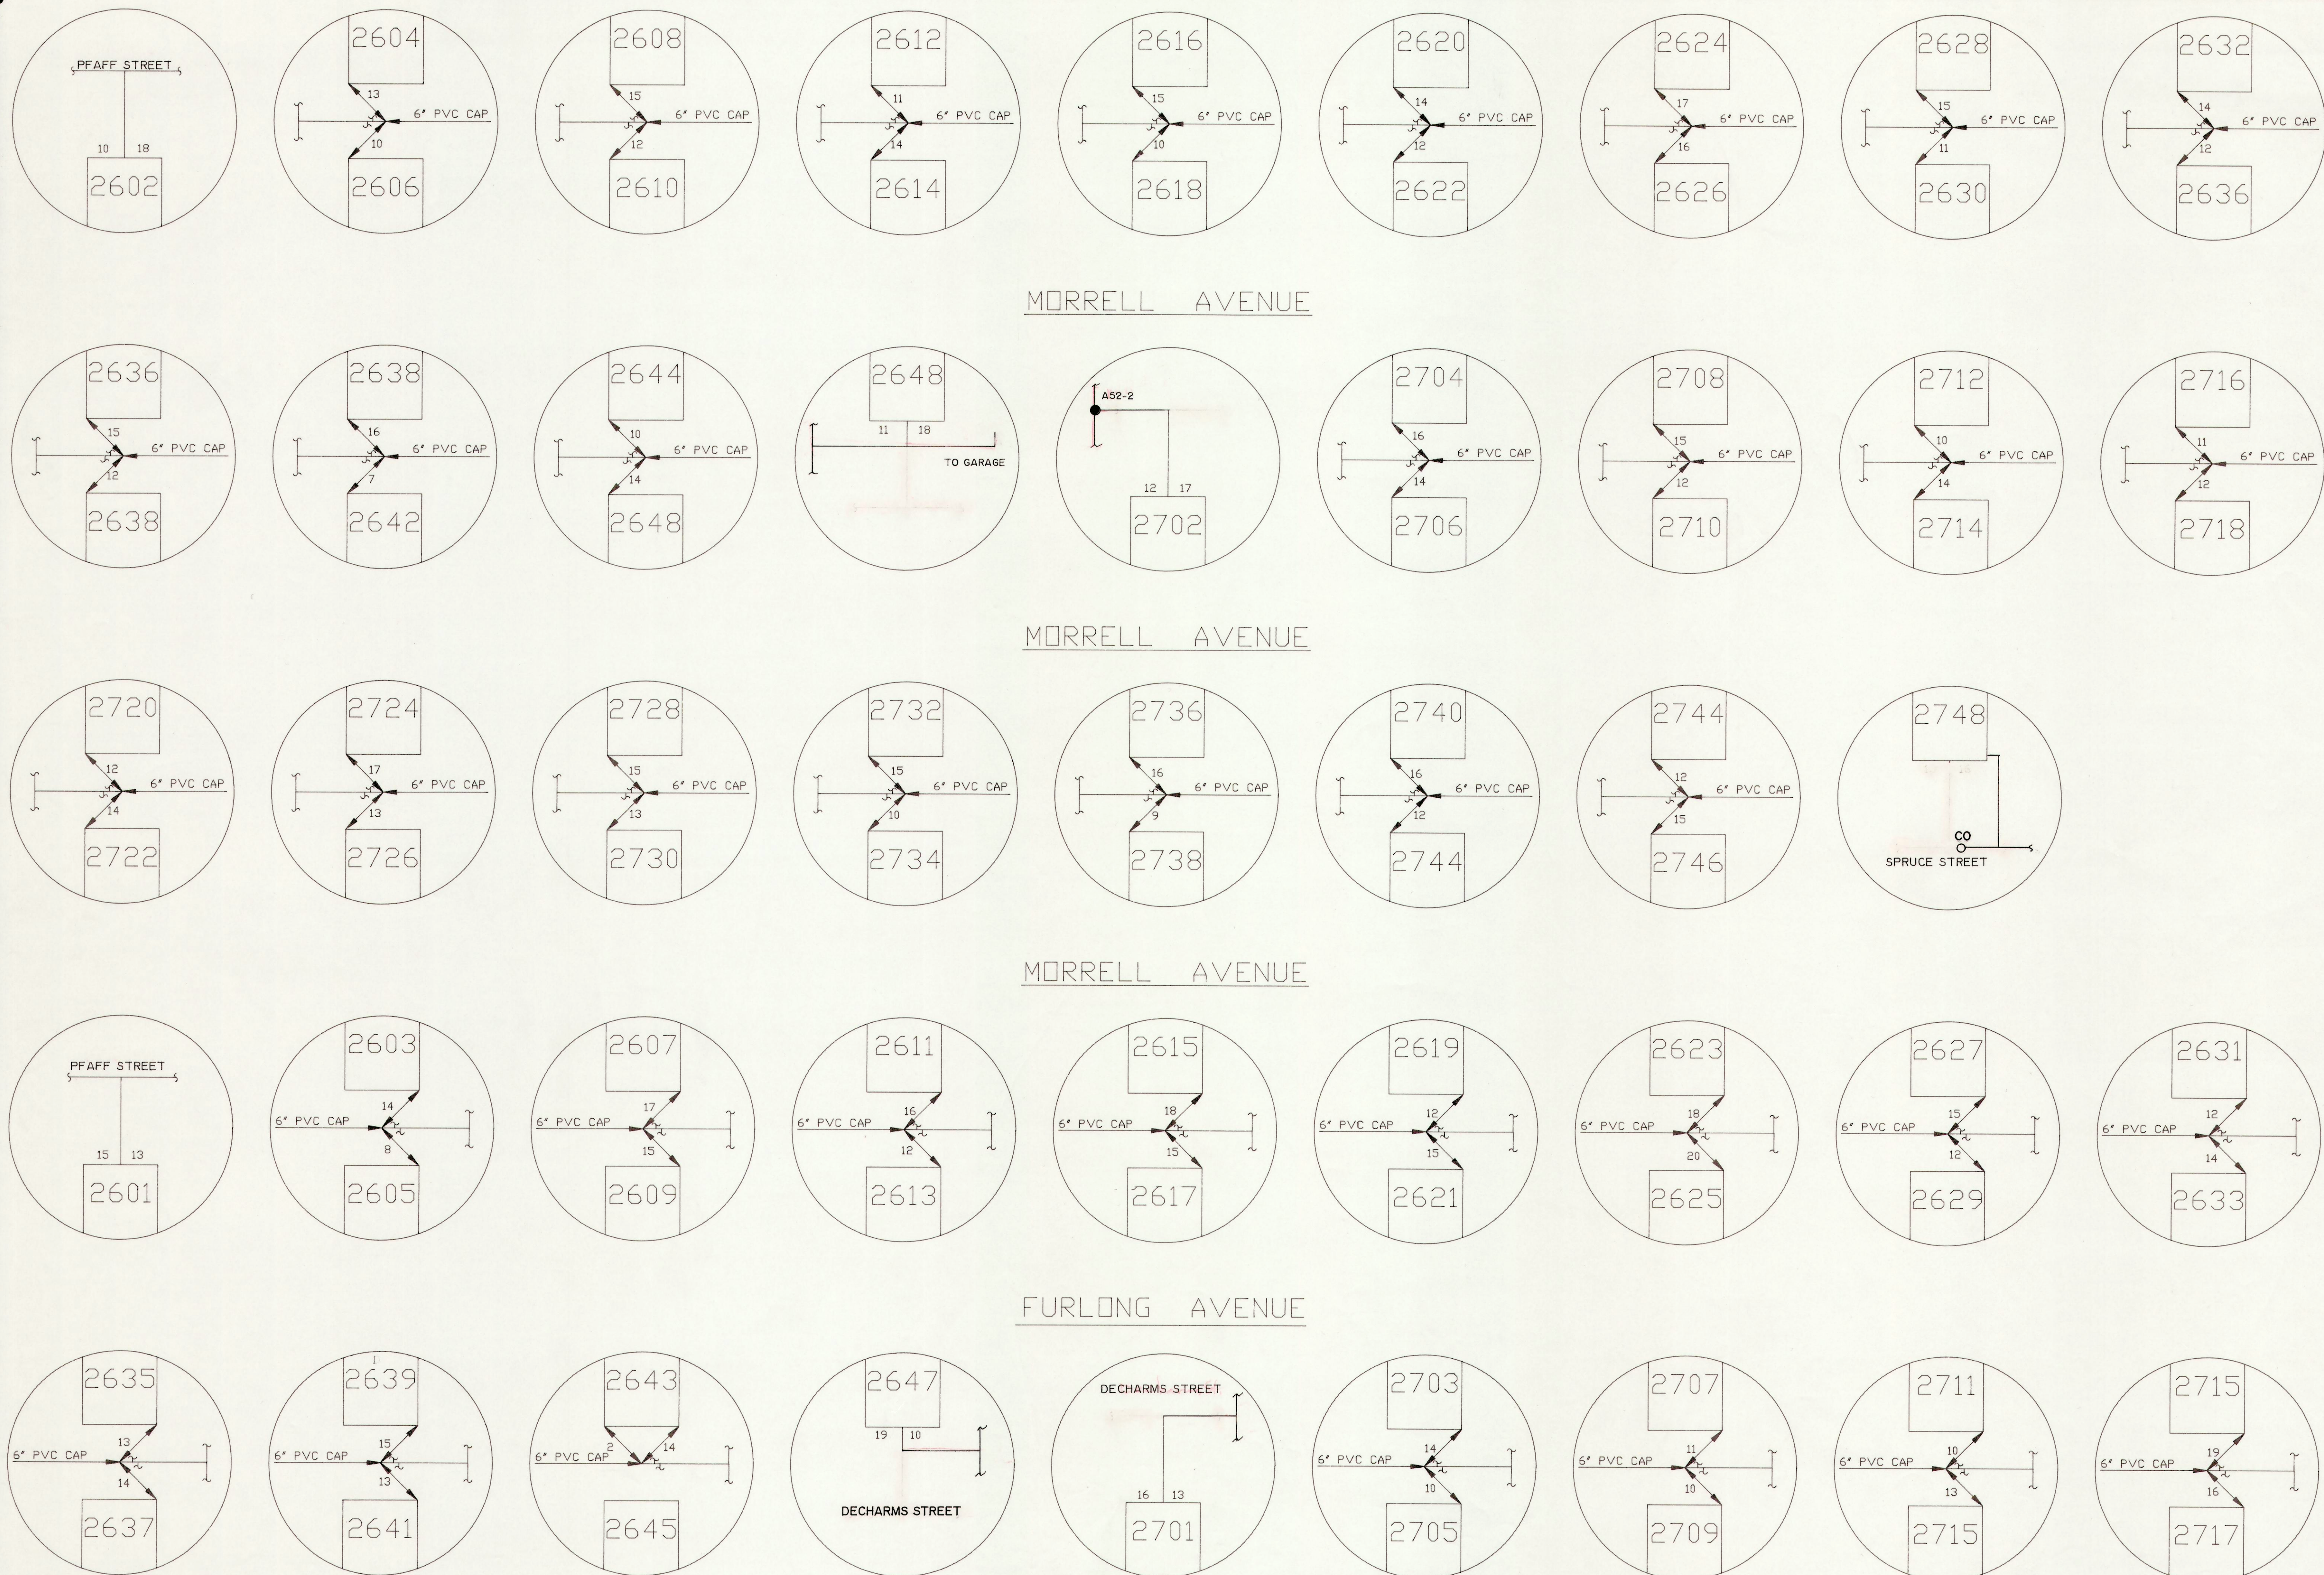

PROJECT INFORMATION
CITY OF ST. ALBANS
MUNICIPAL UTILITY COMMISSION
KANAWHA COUNTY, WEST VIRGINIA
WASTEWATER SYSTEM IMPROVEMENTS
EPA PROJECT NO. C-540618-01
CONTRACT NO. 2

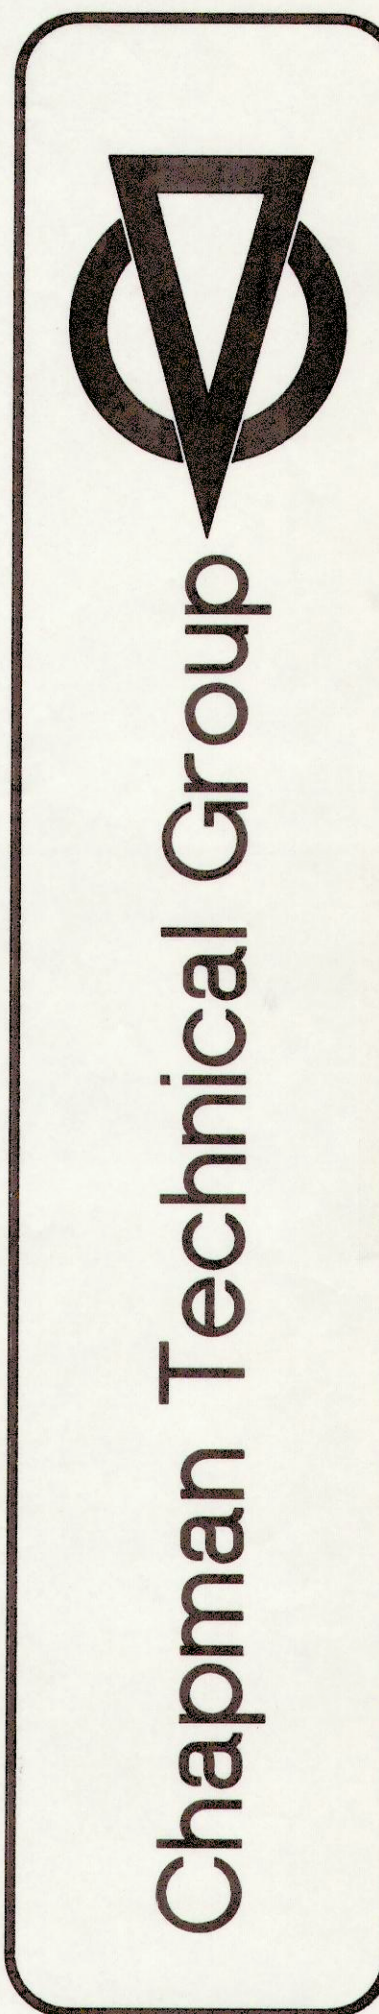

DRAWING TITLE	HOUSE	LATERAL	LOCATIONS
DRAWN	R. OSBORNE		
CHECKED	G. BELCHER		
DATE	DECEMBER, 1991		
SCALE	NONE		
PROJECT NUMBER	67016		
DRAWING NUMBER	9		