


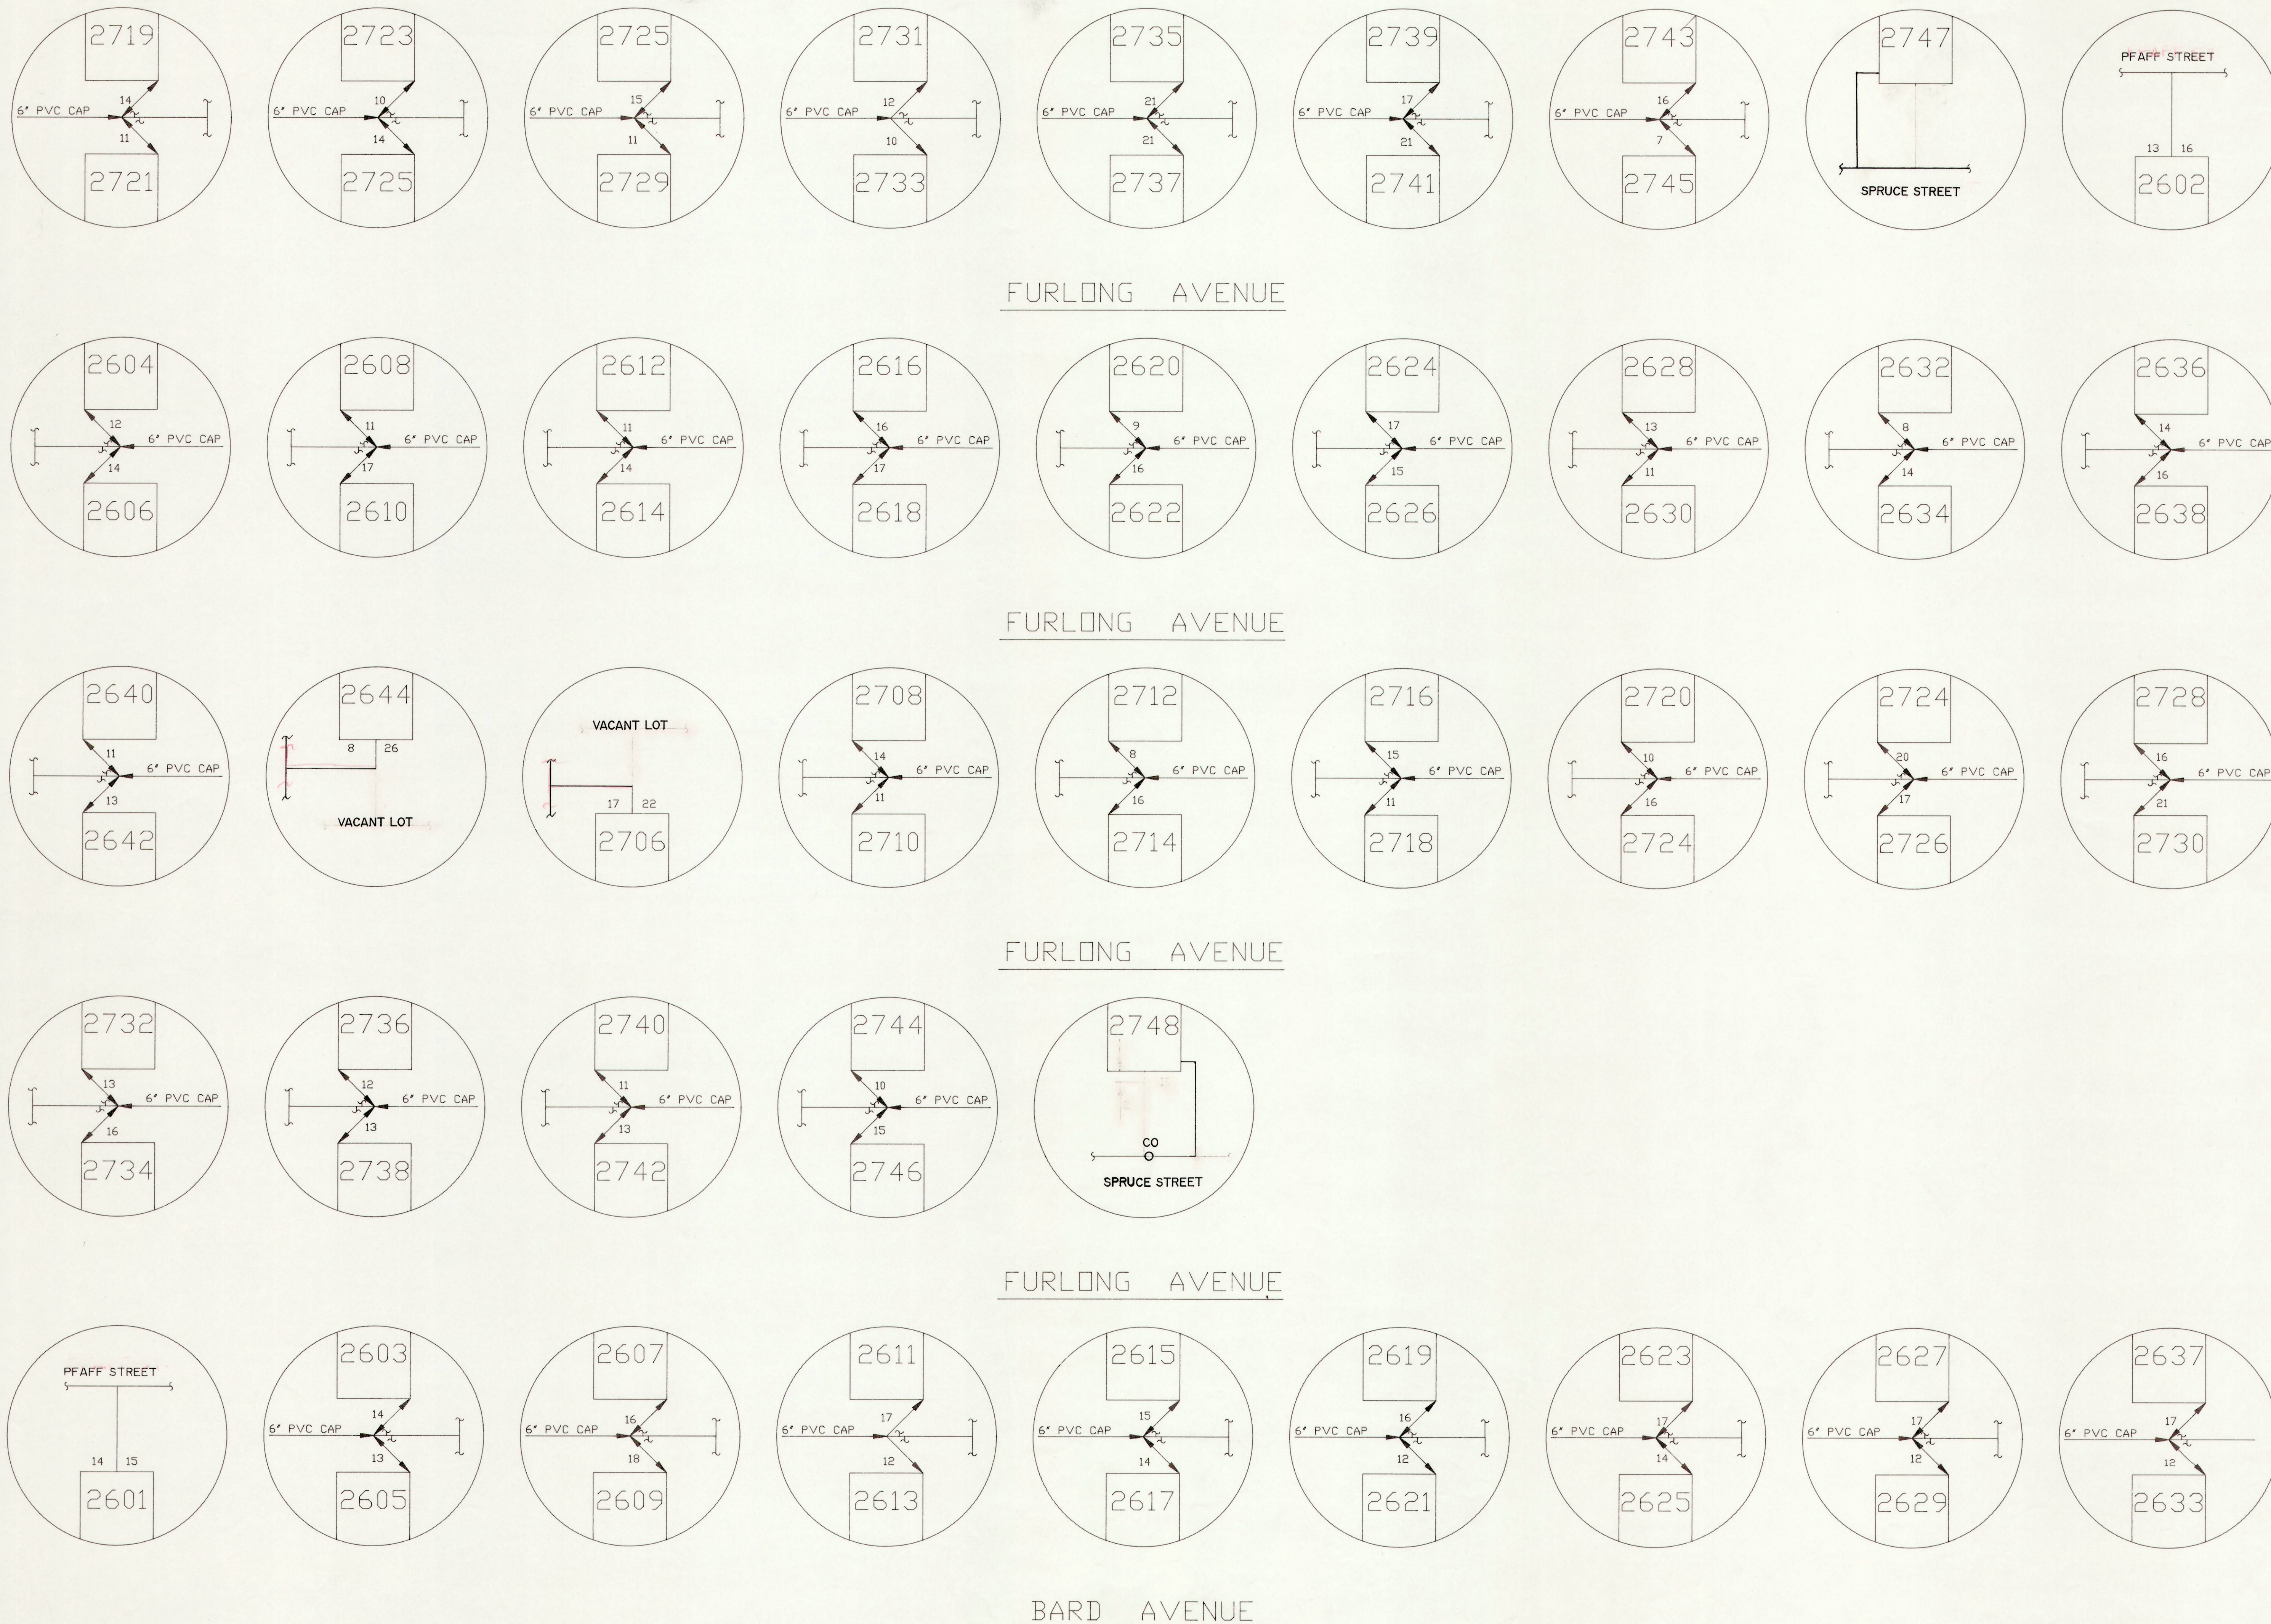

HENRY R. CHAPMAN, P.E.
 REGISTERED PROFESSIONAL ENGINEER
 NO. 6850
 STATE OF VIRGINIA
 PROJECT INFORMATION
 CITY OF ST. ALBANS
 MUNICIPAL UTILITY COMMISSION
 KANAWHA COUNTY, WEST VIRGINIA
 WASTEWATER SYSTEM IMPROVEMENTS
 EPA PROJECT NO. C-940618-01
 CONTRACT NO. 2


 Chapman Technical Group

DRAWING TITLE
 HOUSE LATERAL LOCATIONS
 DRAWN
 R. OSBORNE
 CHECKED
 G. BELCHER
 DATE
 DECEMBER 1991
 SCALE
 NONE
 PROJECT NUMBER
 87016
 DRAWING NUMBER
 10