


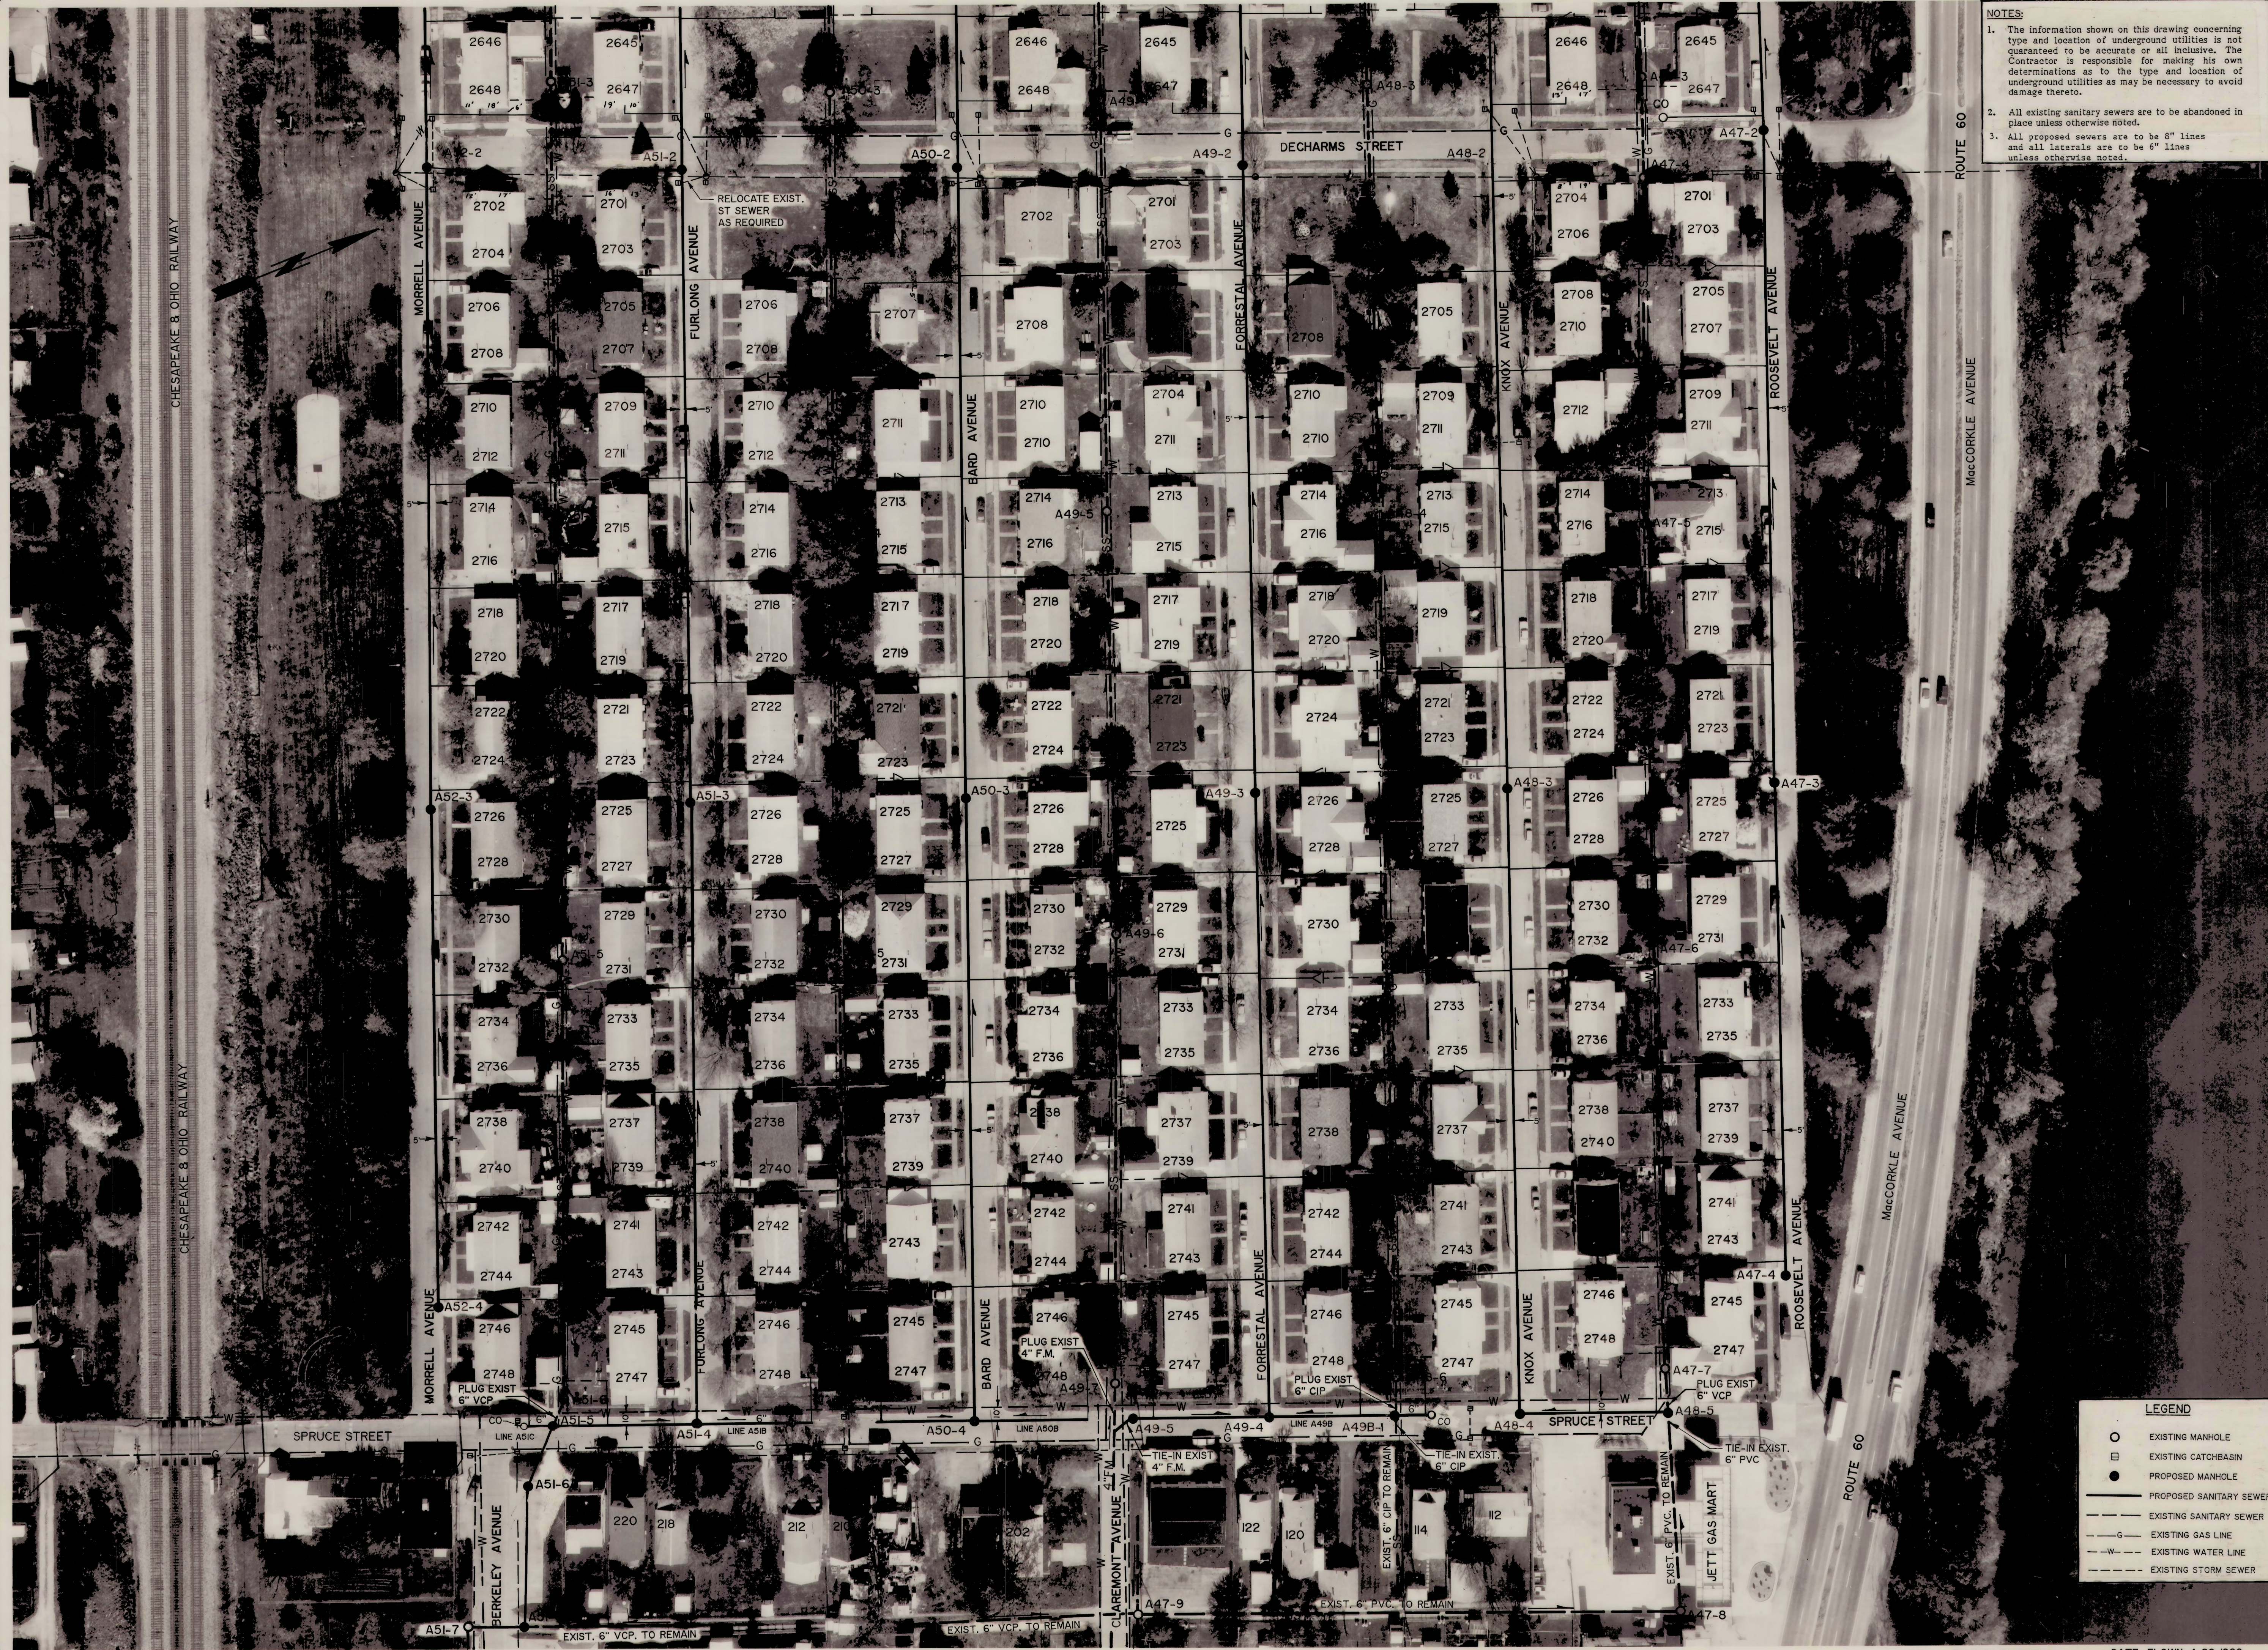

NOTES:

1. The information shown on this drawing concerning type and location of underground utilities is not guaranteed to be accurate or all inclusive. The Contractor is responsible for making his own determinations as to the type and location of underground utilities as may be necessary to avoid damage thereto.
2. All existing sanitary sewers are to be abandoned in place unless otherwise noted.
3. All proposed sewers are to be 8" lines and all laterals are to be 6" lines unless otherwise noted.

PROJECT INFORMATION

CITY OF ST. ALBANS
MUNICIPAL UTILITY COMMISSION
KANAWHA COUNTY, WEST VIRGINIA
WASTEWATER SYSTEM IMPROVEMENTS
EPA PROJECT NO. C-540618-01

REGISTERED PROFESSIONAL ENGINEER
NO. 6850
STATE OF WEST VIRGINIA
HARVEY R. CHAPMAN, P.E.

CONTRACT NO. 2


Chapman Technical Group

DRAWING TITLE

WASTEWATER COLLECTION SYSTEM
PLAN SHEET

DRAWN BY
R. OSBORNE, P. ARTHUR

CHECKED BY
G. BELCHER

DATE
FEBRUARY, 1999

SCALE
1" = 50'

PROJECT NUMBER
87016

DRAWING NUMBER
2

LEGEND

- EXISTING MANHOLE
- EXISTING CATCHBASIN
- PROPOSED MANHOLE
- PROPOSED SANITARY SEWER
- EXISTING SANITARY SEWER
- EXISTING GAS LINE
- EXISTING WATER LINE
- EXISTING STORM SEWER