


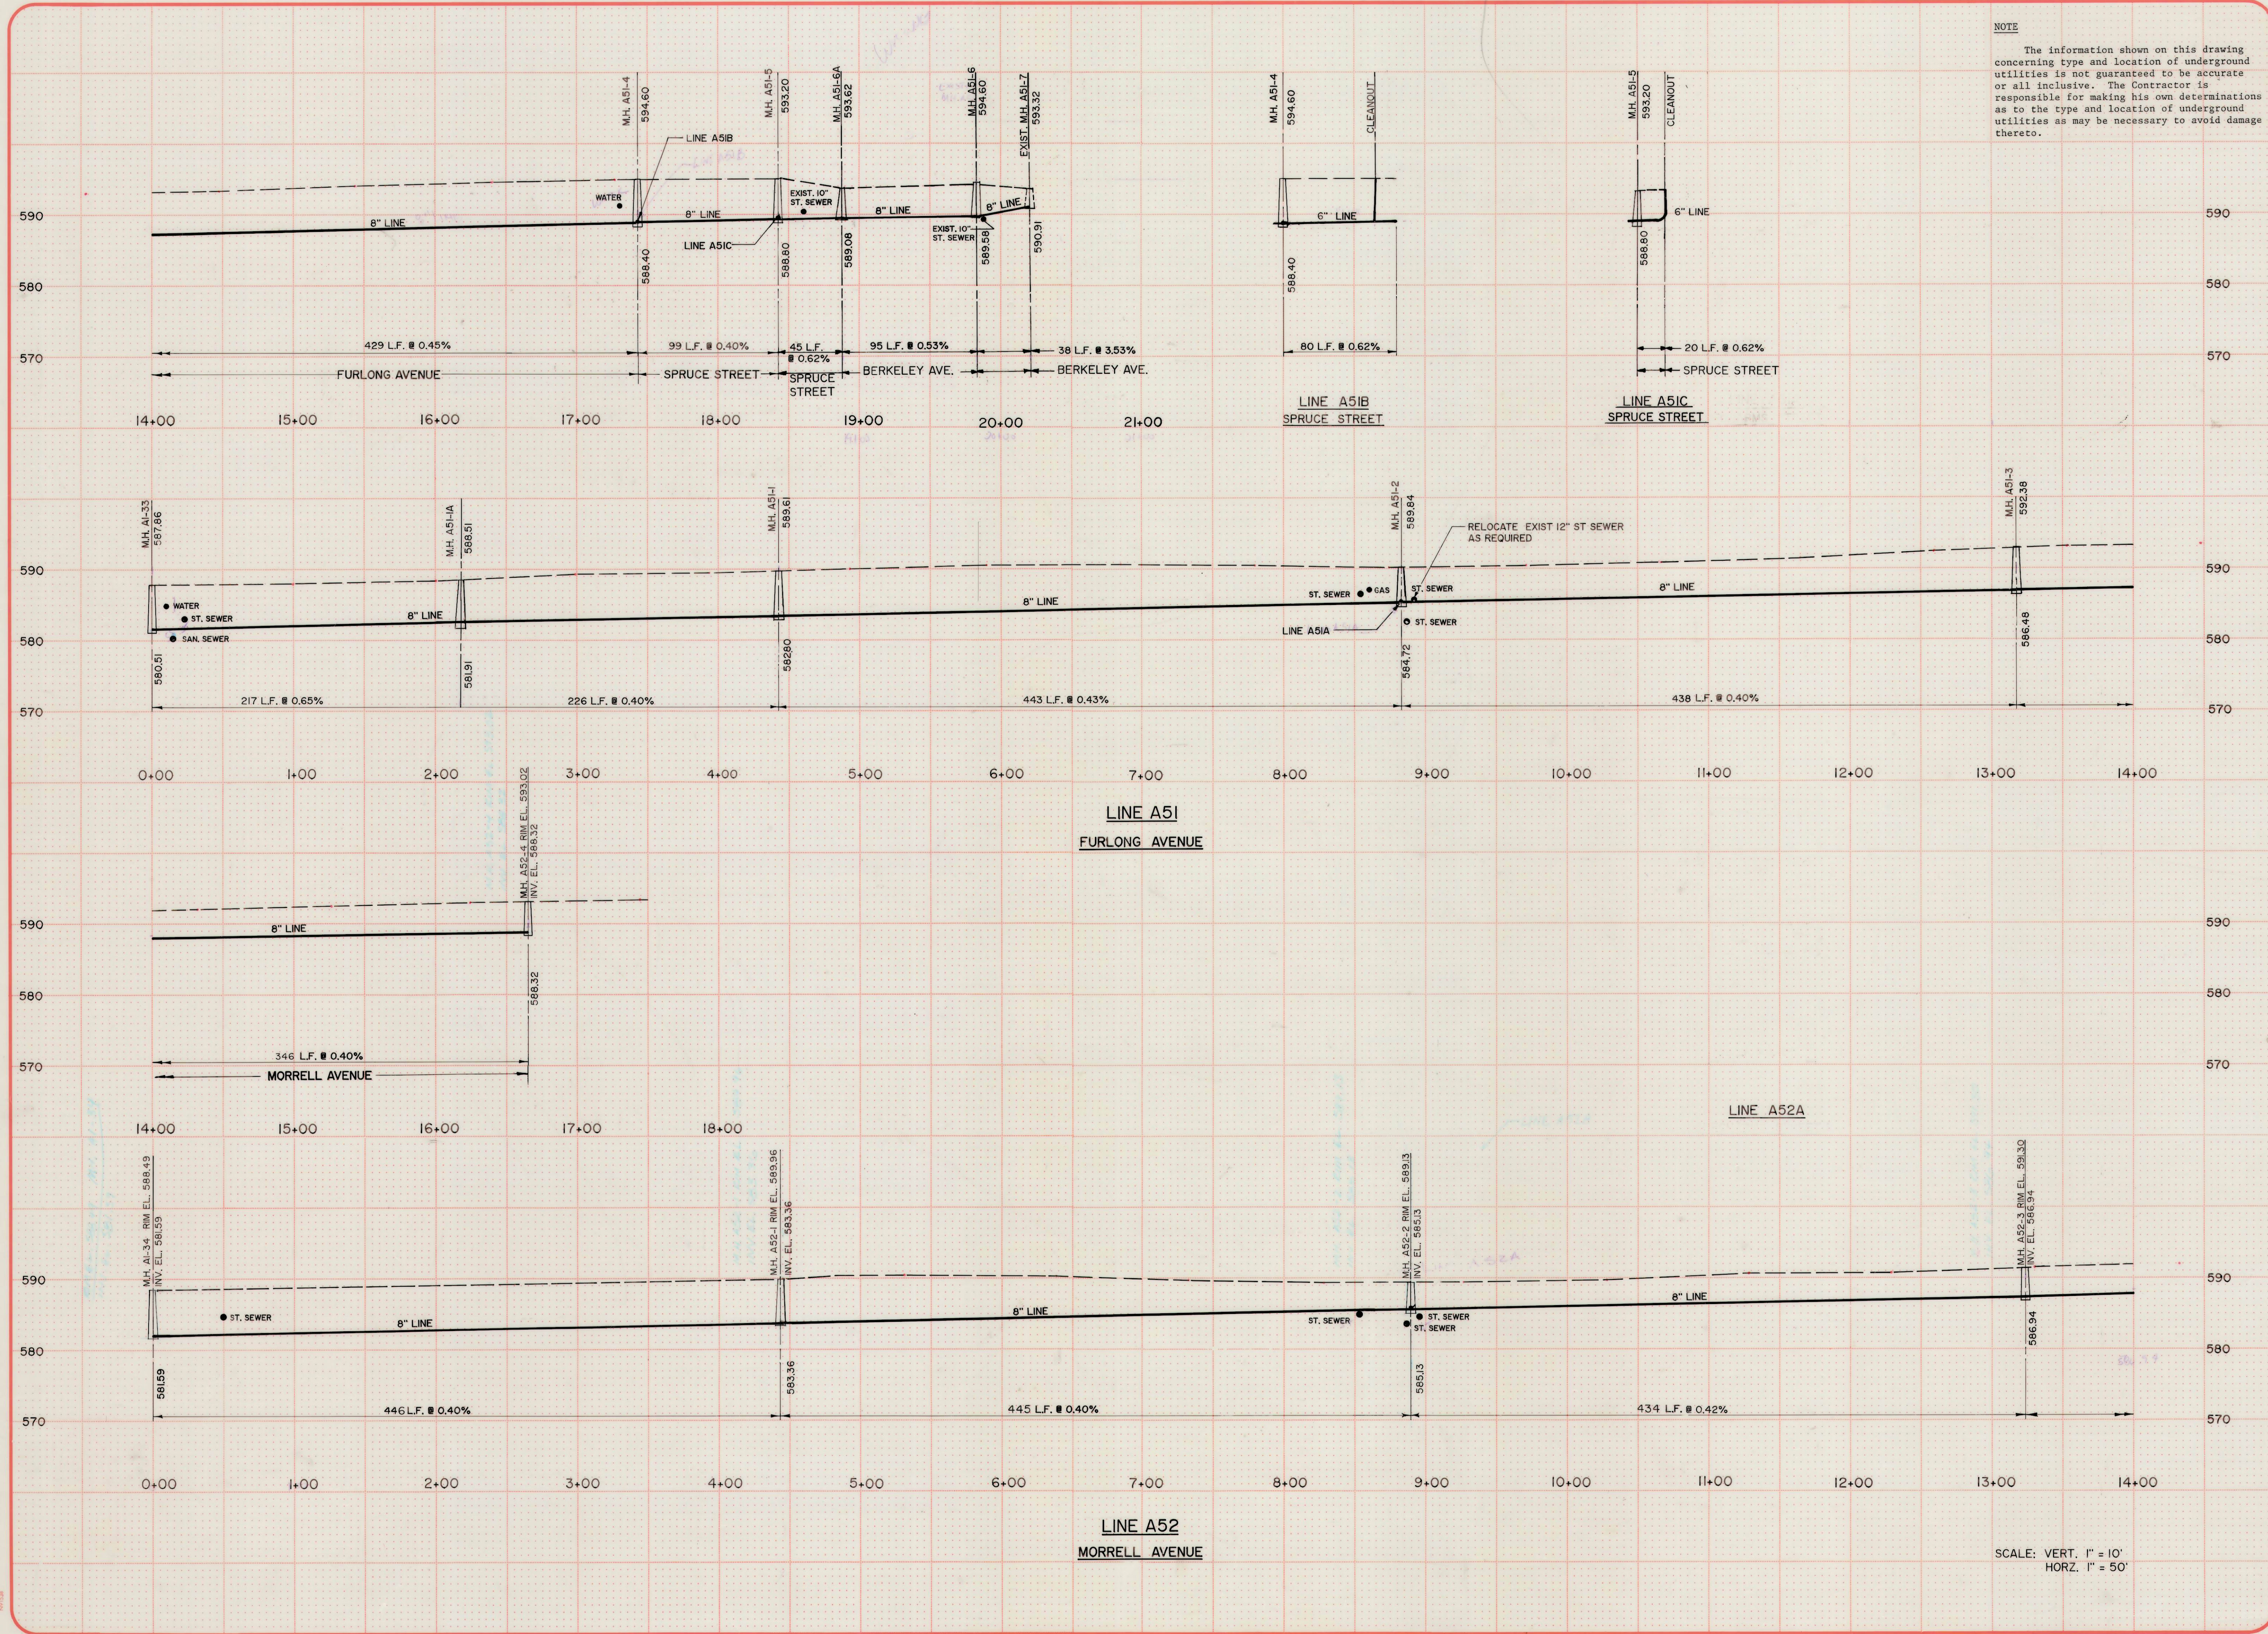

NOTE  
The information shown on this drawing concerning type and location of underground utilities is not guaranteed to be accurate or all inclusive. The Contractor is responsible for making his own determinations as to the type and location of underground utilities as may be necessary to avoid damage thereto.

PROJECT INFORMATION  
CITY OF ST. ALBANS  
MUNICIPAL UTILITY COMMISSION  
KANAWHA COUNTY, WEST VIRGINIA  
WASTEWATER SYSTEM IMPROVEMENTS  
EPA PROJECT NO. C-540618-01  
CONTRACT NO. 2

Chapman Technical Group

DRAWING TITLE  
PROFILE  
LINES A51, A51A @ B, A52, A52A  
FURLONG AVENUE  
MORRELL AVENUE

DRAWN  
R. OSBORNE  
CHECKED  
G. BELCHER  
DATE  
AUGUST, 1989  
AS SHOWN  
PROJECT NUMBER  
87016  
DRAWING NUMBER  
3

SCALE: VERT. 1" = 10'  
HORZ. 1" = 50'