

NOTE
The information shown on this drawing concerning type and location of underground utilities is not guaranteed to be accurate or all inclusive. The Contractor is responsible for making his own determinations as to the type and location of underground utilities as may be necessary to avoid damage thereto.

PROJECT INFORMATION

REGISTERED
NO. 6850
STATE OF
WEST VIRGINIA
PROFESSIONAL ENGINEER

CITY of ST. ALBANS
MUNICIPAL UTILITY COMMISSION
KANAWHA COUNTY, WEST VIRGINIA
WASTEWATER SYSTEM IMPROVEMENTS
EPA PROJECT No. C-540618-01

CONTRACT No. 2


Chapman Technical Group

DRAWING TITLE

PROFILE
LINE A1
PFAFF STREET

DESIGNED
R. OSBORNE


CHECKED
G. BELCHER

DATE
AUGUST, 1989

AS SHOWN

PROJECT NUMBER
87016

DRAWING NUMBER
6

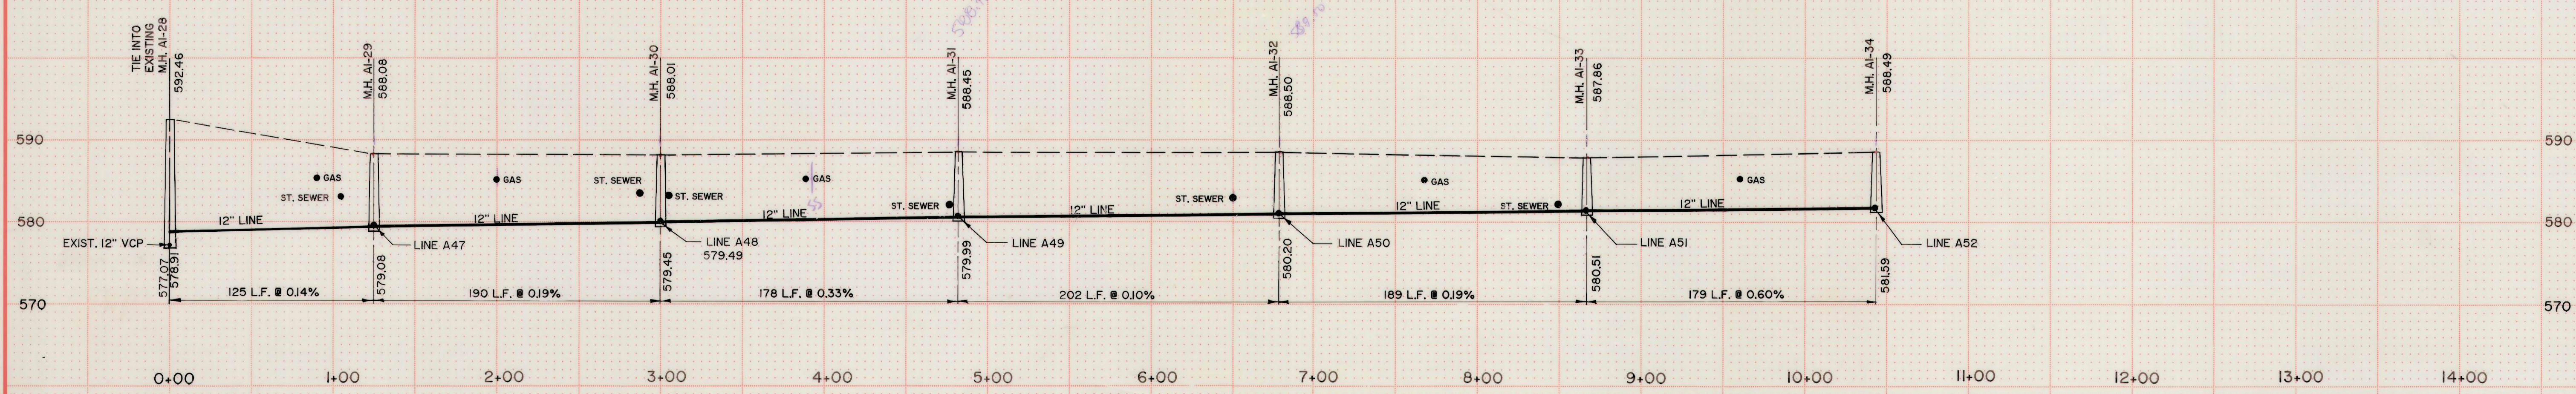

LINE A1
PFAFF STREET

SCALE: VERT. 1" = 10'
HORZ. 1" = 50'