N2W3

22-1

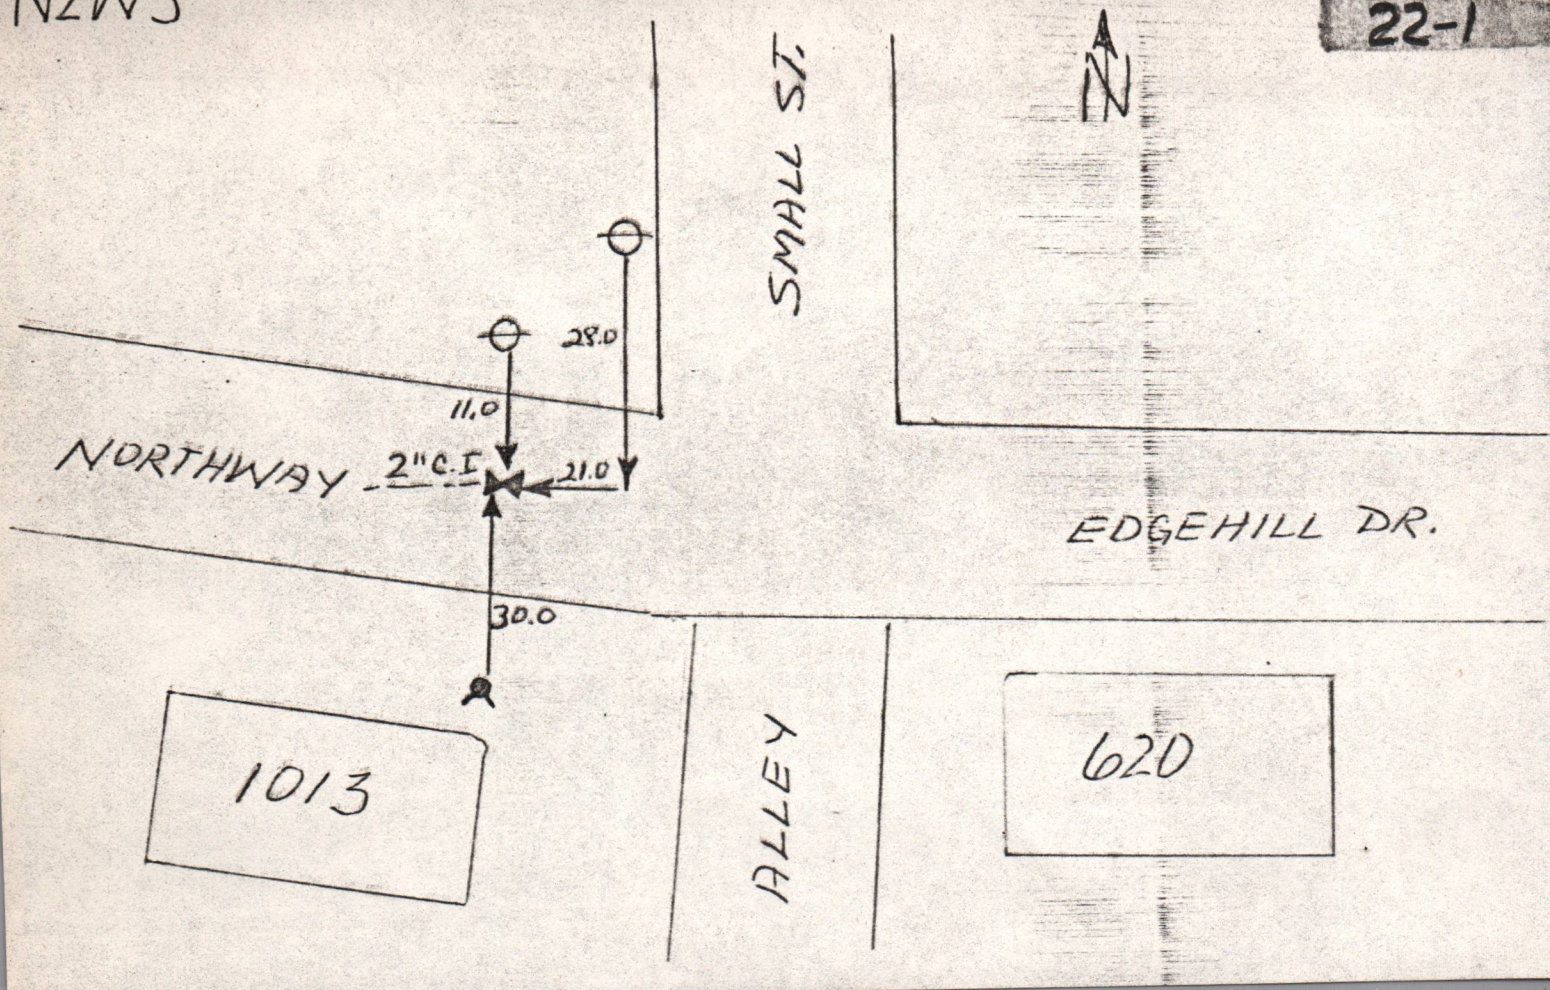

K&M CO. TORRANCE, CA. SP 65 CLEAR