


8-1

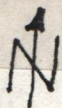

N4W4

6" C.I.

16.0'

36.0'

30'

T.P.

21.8'

SIXth AVE.

4th STREET

LIBRARY

