S2E2

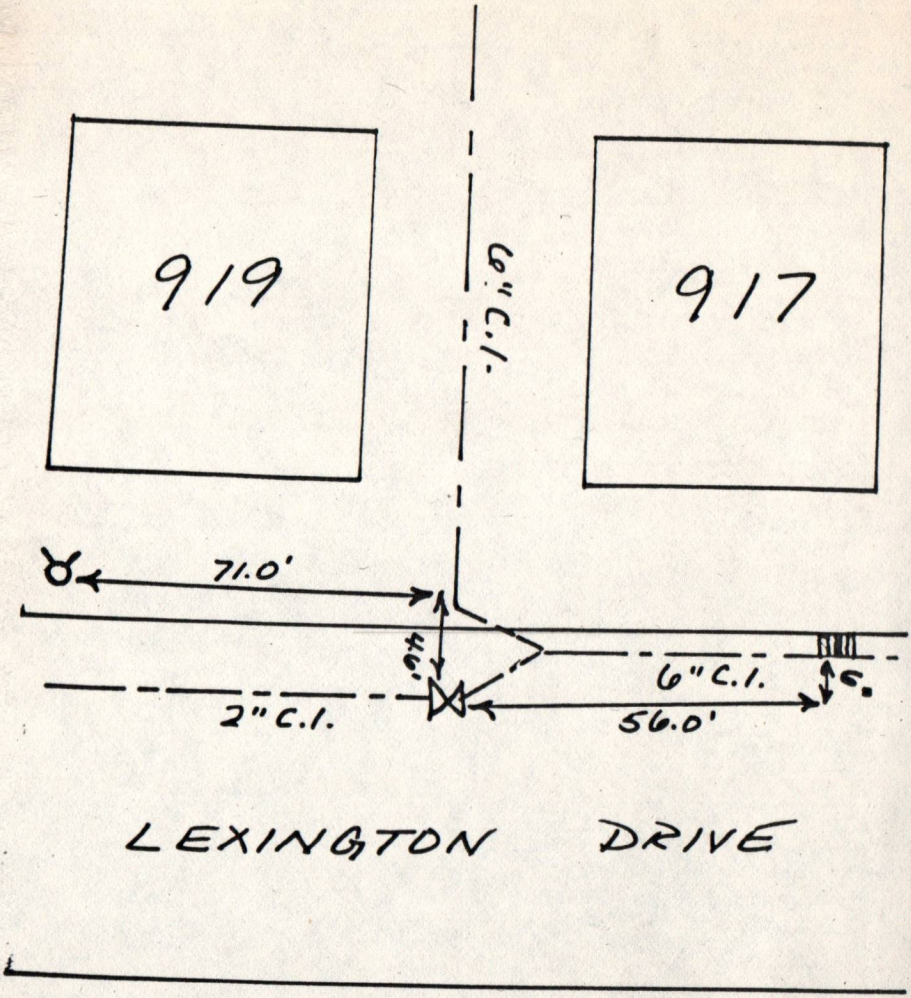

22-5